

RECEIVED

JAN 10 1958  
STATE ENGINEER  
SALEM, OREGON

REGISTRATION NO. GR-71

CERTIFICATE NO. GR-61

Registration Statement

OF CLAIMANT OF RIGHT TO APPROPRIATE GROUND WATER

(Under Chapter 708, Oregon Laws 1955.)

TO THE STATE ENGINEER OF OREGON:

I, Ben Fisher

of Siletz County of Marion

State of Ore, do hereby make application for a certificate of registration as evidence of a right to appropriate ground water.

1. Source from which water is withdrawn is pump well  
(Flowing well, pump well, infiltration trench, or tunnel)

2. Location is: 3 1/2 N.E. from Siletz  
(Approximate distance and direction from nearest city or town)

and is more particularly described as follows:

(a) approximately 350 ft. E & 300 ft. S from NW corner  
(Give distance and bearing to corner of section or other legal subdivision)

being within NW 1/4 NW 1/4 of Sec. 11, Twp. 6 S, Rge. 1 E Sec 19  
(Smallest legal subdivision) (N. or S.) (E. or W.)

or (b) within limits of recorded platted property, town or city:

in Lot \_\_\_\_\_, Block \_\_\_\_\_ of \_\_\_\_\_  
(Name of plat or addition)

County of \_\_\_\_\_  
(If within city or town, give name)

3. Construction Work was begun on March 1957, was completed on March 1957  
(Date) (Date)

and the ground water claimed was first used for the purposes set out below on March 1957  
(Date)

since which time the water has been used during the season  
(Continuously or intermittently)

from 1951 to present  
(Date) (Date)

4. Quantity of water claimed and used is 4.5 gallons per minute; 5 acre feet per year.

5. Purpose or Purposes for which water is used irrigation  
(Domestic, irrigation, municipal, manufacturing, industrial, etc.)

6. Description of Well: Depth 100 feet. Type drilled  
(Dug or drilled)

diameter 6 inches. Elevation of ground at well site \_\_\_\_\_ feet, mean sea level.  
(As near as known)

Depth to water table 6 feet.

7. Capacity of Well: unknown with \_\_\_\_\_ feet drawdown.

\_\_\_\_\_ g.p.m. with \_\_\_\_\_ feet drawdown.

Date of test none

If Flowing Well: Measured discharge \_\_\_\_\_ g.p.m. on \_\_\_\_\_  
(Date)


Shut-in pressure at ground surface \_\_\_\_\_ lbs. per sq. in. on \_\_\_\_\_  
(Date)

Water is controlled by \_\_\_\_\_  
(Cap, valve, etc.)





Township 6S Range 1E, W.M.  
North

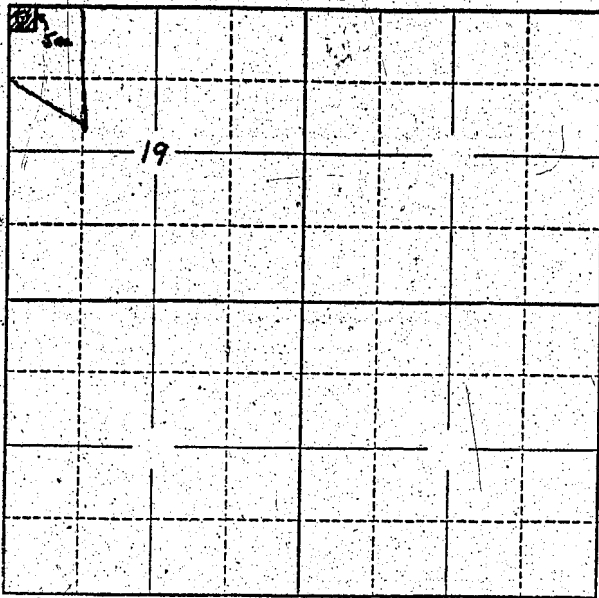

Locate well and acreage of irrigated land on plat.  
Scale: 2" = 1 Mile

STATE OF OREGON }  
County of Marion } ss.

I, Ben Fisher, being first duly sworn, do hereby certify that I have read the foregoing Registration Statement and that all of the items therein contained are true to the best of my knowledge and belief.

Ben Fisher  
(Signature of Registrant)

Subscribed and sworn to before me this 19 day of January, 1956

My commission expires Dec. 20, 1957 Elizabeth Swanson  
(Notary Public)

(SEAL)

**CERTIFICATE OF REGISTRATION**

STATE OF OREGON }  
County of Marion } ss.

This is to certify that the foregoing Registration Statement was received in the office of the State Engineer on the 10th day of January, 1956, at 10:00 o'clock A. M. and has been duly recorded in said office in Book No. 1 of Registration Statements on page 61

Construction shall be completed by 15, 1956, and the water is completely applied to beneficial use by 15, 1956.

Witness my hand this 29th day of February, 1956  
Leona A. Stanley  
(State Engineer)

By \_\_\_\_\_  
(Deputy)