

Registration Statement

OF CLAIMANT OF RIGHT TO APPROPRIATE GROUND WATER

TO THE STATE ENGINEER OF OREGON:

I, Robert P. Richardson

of Rt 2, Box 385 Albany County of Linn

State of Oregon do hereby make application for a certificate of registration as evidence of a right to appropriate ground water.

1. Source from which water is withdrawn is Pump Well

(Flowing well, pump well, infiltration trench, or tunnel)

2. Location is: 12 Miles from Albany

(Approximate distance and direction from nearest city or town)

and is more particularly described as follows:

(a) 1250 feet west and 680 feet north from SE corner section 2

(Give distance and bearing to corner of section or other legal subdivision)

being within SE 1/4 of SE 1/4 of Sec. 2, Twp. 10 S, Rge. 4 W

(Smallest legal subdivision)

(N. or S.)

(E. or W.)

or (b) within limits of recorded platted property, town or city:

in Lot _____, Block _____ of _____

(Name of plat or addition)

County of _____

(If within city or town, give name)

3. Construction Work was begun on Feb 1949; was completed on May 1949

(Date)

(Date)

and the ground water claimed was first used for the purposes set out below on May 1949

(Date)

since which time the water has been used Continuously

(Continuously or Intermittently)

from May 1949 to Sept 1957

(Date)

(Date)

4. Quantity of water claimed and used is 350 gallons per minute; _____ acre feet per year.

5. Purpose or Purposes for which water is used: Irrigation for Farm Crops

(Domestic, irrigation, municipal, manufacturing, industrial, etc.)

6. Description of Well: Depth 30 feet. Type Drilled

(Dug or drilled)

diameter 10 inches. Elevation of ground at well site 170 feet, mean sea level.

(As near as known)

Depth to water table 10 feet.

7. Capacity of Well: 800 g.p.m. with 2 feet drawdown.

_____ g.p.m. with _____ feet drawdown.

Date of test May 1949

If Flowing Well: Measured discharge _____ g.p.m. on _____

(Date)

Shut-in pressure at ground surface _____ lbs. per sq. in. on _____


(Date)

Water is controlled by _____

(Cap. valve, etc.)

well #2

Township 10S Range 4W W.M.
North

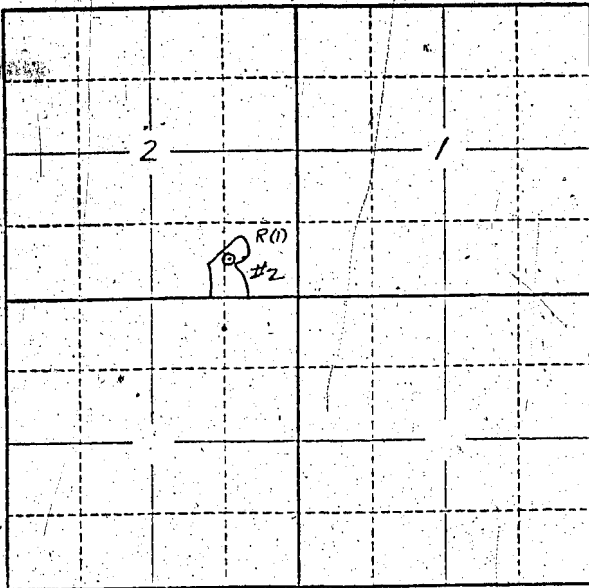

Locate well and acreage of irrigated land on plat.
Scale: 2" = 1 Mile

STATE OF OREGON

County of Marion } ss.

I, Robert P. Richardson, being first duly sworn, do hereby certify that I have read the foregoing Registration Statement and that all of the items therein contained are true to the best of my knowledge and belief.

Robert P. Richardson
(Signature of Registrant)

Subscribed and sworn to before me this 14th day of November, 1957.

My commission expires June 12th, 1961. *Wm. S. Bartholomew*
(Notary Public)

(SEAL)

CERTIFICATE OF REGISTRATION

STATE OF OREGON } ss.
County of Marion

This is to certify that the foregoing Registration Statement was received in the office of the State Engineer on the 14th day of November, 1957, at 12:00 o'clock A.M. and has been duly recorded in said office in Book No. of Registration Statements on page GR-692 C.

Witness my hand this 21st day of January, 1958.

Lewis A. Stanley
(State Engineer)

By _____
(Deputy)

#1550