

# Registration Statement

## OF CLAIMANT OF RIGHT TO APPROPRIATE GROUND WATER

TO THE STATE ENGINEER OF OREGON:

I, Robert P. Richardson  
of Box 385 Albany County of Linn  
(Mailing address)

State of Oregon do hereby make application for a certificate of registration as evidence of a right to appropriate ground water.

- 1. Source from which water is withdrawn is #1  
(Flowing well, pump well, infiltration trench, or tunnel)
- 2. Location is: 12 miles from Albany  
(Approximate distance and direction from nearest city or town)

and is more particularly described as follows:

(a) 2000 ft north and 580 ft west from SE corner section 2  
(Give distance and bearing to corner of section or other legal subdivision)  
being within NE 1/4 of SE 1/4 of Sec. 2, Twp. 10 S, Rge. 4 W  
(Smallest legal subdivision) (N. or S.) (E. or W.)

or (b) within limits of recorded platted property, town or city:  
in Lot \_\_\_\_\_, Block \_\_\_\_\_ of \_\_\_\_\_  
(Name of plat or addition)  
\_\_\_\_\_ County of \_\_\_\_\_  
(If within city or town, give name)

3. Construction Work was begun on Feb 1947; was completed on Mar 1947  
(Date) (Date)

and the ground water claimed was first used for the purposes set out below on May 1947  
(Date)  
since which time the water has been used Continuously during Farming Seasons  
(Continuously or Intermittently)  
from May 1947 to Sept 1957  
(Date) (Date)

4. Quantity of water claimed and used is 430 gallons per minute; \_\_\_\_\_ acre feet per year.

5. Purpose or Purposes for which water is used Irrigation for Farm Crops  
(Domestic, irrigation, municipal, manufacturing, industrial, etc.)

6. Description of Well: Depth 30 feet. Type Drilled  
(Dig or drilled)  
diameter 10 inches. Elevation of ground at well site 170' feet, mean sea level.  
(As near as known)  
Depth to water table 10 feet.

7. Capacity of Well: 800 g.p.m. with 2 feet drawdown.  
\_\_\_\_\_ g.p.m. with \_\_\_\_\_ feet drawdown.

Date of test Mar 1947

If Flowing Well: Measured discharge \_\_\_\_\_ g.p.m. on \_\_\_\_\_  
(Date)

Shut-in pressure at ground surface \_\_\_\_\_ lbs. per sq. in. on \_\_\_\_\_  
(Date)


Water is controlled by \_\_\_\_\_  
(Cap, valve, etc.)





Well #1

Township 10 S Range 4 W W.M.  
North

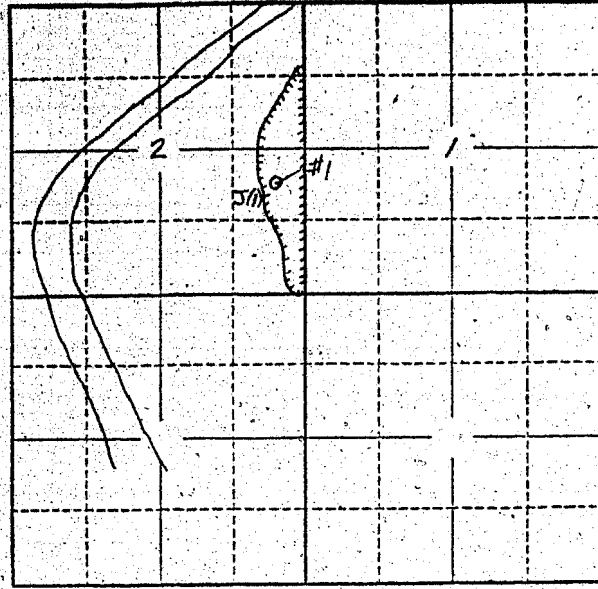

Locate well and acreage of irrigated land on plat.  
Scale: 2" = 1 Mile

STATE OF OREGON }  
County of Marion } ss.

I, Robert P. Richardson, being first duly sworn, do hereby certify that I have read the foregoing Registration Statement and that all of the items therein contained are true to the best of my knowledge and belief.

Robert P. Richardson  
(Signature of Registrant)

Subscribed and sworn to before me this 14th day of November, 1957.

My commission expires June 12th, 1961 Wm. S. Bartholomew  
(Notary Public)

(SEAL)

**CERTIFICATE OF REGISTRATION**

STATE OF OREGON }  
County of Marion } ss.

This is to certify that the foregoing Registration Statement was received in the office of the State Engineer on the 14th day of November, 1957, at 12:00 o'clock A. M. and has been duly recorded in said office in Book No. 4 of Registration Statements on page GR-693 C.

Witness my hand this 21st day of January, 1958

Lewis A. Stanley  
(State Engineer)

By \_\_\_\_\_  
(Deputy)

# 20<sup>25</sup>