

Registration No. GR. 713

Certificate No. GR. 694

# Registration Statement

## OF CLAIMANT OF RIGHT TO APPROPRIATE GROUND WATER

TO THE STATE ENGINEER OF OREGON:

I, Clyde S. Millsap

of Corvallis County of Benton

(Mailing address)

State of Oregon, do hereby make application for a certificate of registration as evidence of a right to appropriate ground water.

1. Source from which water is withdrawn is pumpwells #1

(Flowing well, pump well, infiltration trench, or tunnel)

2. Location is: 2 1/2 miles NE of Corvallis

(Approximate distance and direction from nearest city or town)

and is more particularly described as follows:

Well #1 3.2 chains W and 7.7 chains S of the SW corner of the James H. Stewart D.L.C.

(a) No. 19, Twp. 11 S., R. 4 W., Will. Mer., in the NW 1/4 of the SW 1/4 of Sec. 30

(Give distance and bearing to corner of section or other legal subdivision)

being within NW 1/4 of SW 1/4 of Sec. 30, Twp. 11 S., Rge. 4 W.

(Smallest legal subdivision)

(N. or S.)

(E. or W.)

or (b) within limits of recorded platted property, town or city:

in Lot \_\_\_\_\_, Block \_\_\_\_\_ of \_\_\_\_\_

(Name of plat or addition)

\_\_\_\_\_ County of \_\_\_\_\_

(If within city or town, give name)

3. Construction Work was begun on Previous to 1945; was completed on same

(Date)

(Date)

and the ground water claimed was first used for the purposes set out below on previous to 1945

(Date)

since which time the water has been used continuously

(Continuously or intermittently)

from before 1945 to present

(Date)

(Date)

4. Quantity of water claimed and used is 100 gallons per minute; 28.6 acre feet per year.

5. Purpose or Purposes for which water is used truck crops

(Domestic, irrigation, municipal, manufacturing, industrial, etc.)

6. Description of Well: Depth 30 feet. Type drilled

(Dug or drilled)

diameter 5 inches. Elevation of ground at well site 210 feet, mean sea level.

(As near as known)

Depth to water table 10 feet.

7. Capacity of Well: 225 g.p.m. with 1 feet drawdown.

\_\_\_\_\_ g.p.m. with \_\_\_\_\_ feet drawdown.

Date of test before 1945

If Flowing Well: Measured discharge \_\_\_\_\_ g.p.m. on \_\_\_\_\_

(Date)

Shut-in pressure at ground surface \_\_\_\_\_ lbs. per sq. in. on \_\_\_\_\_

(Date)


Water is controlled by \_\_\_\_\_

(Cap, valve, etc.)





Township 115 Range 44, W.M.  
North

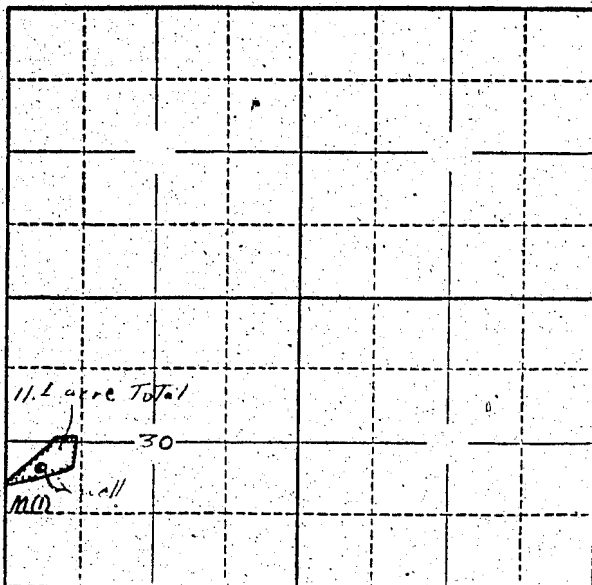

Locate well and acreage of irrigated land on plat.  
Scale: 2" = 1 Mile

STATE OF OREGON

County of BENTON

} ss.

I, CLYDE S. MILLSAP, being first duly sworn, do hereby certify that I have read the foregoing Registration Statement and that all of the items therein contained are true to the best of my knowledge and belief.

Clyde S. Millsap  
(Signature of Registrant)

Subscribed and sworn to before me this 6th day of November, 19 57.

NOTARY PUBLIC FOR OREGON  
My commission expires March 29, 1960

Anne D. Travis  
(Notary Public)

(SEAL)

**CERTIFICATE OF REGISTRATION**

STATE OF OREGON

County of Marion

} ss.

This is to certify that the foregoing Registration Statement was received in the office of the State Engineer on the 15th day of November, 19 57, at 1:00 o'clock P. M. and has been duly recorded in said office in Book No. 1 of Registration Statements on page GR-691 C

Witness my hand this 21th day of January

19 58  
Leora A. Stanley  
(State Engineer)

By \_\_\_\_\_  
(Deputy)