

Registration Statement

OF CLAIMANT OF RIGHT TO APPROPRIATE GROUND WATER

TO THE STATE ENGINEER OF OREGON:

I, Clyde S. Hillsap

of Corvallis County of Benton

State of Oregon, do hereby make application for a certificate of registration as evidence of a right to appropriate ground water.

1. Source from which water is withdrawn is pumpwell #3
(Flowing well, pump well, infiltration trench, or tunnel)

2. Location is: 2 1/2 miles NE of Corvallis
(Approximate distance and direction from nearest city or town)

and is more particularly described as follows:

Well #3 3.7 chains E and 41.7 chains N of the SW corner of said claim, in the
(a) SW 1/4 of the SW 1/4 of Sec. 19

(Give distance and bearing to corner of section or other legal subdivision)
being within SW 1/4 of SW 1/4 of Sec. 19, Twp. 11 S, Rge. 1 W
(Smallest legal subdivision) (N. or S.) (E. or W.)

or (b) within limits of recorded platted property, town or city:

in Lot _____, Block _____ of _____
(Name of plat or addition)

County of _____
(If within city or town, give name)

3. Construction Work was begun on previous to 1945; was completed on same
(Date) (Date)

and the ground water claimed was first used for the purposes set out below on previous to 1945
(Date)

since which time the water has been used continuously
(Continuously or intermittently)

from before 1945 to present
(Date) (Date)

4. Quantity of water claimed and used is 100 gallons per minute; 43.5 acre feet per year.

5. Purpose or Purposes for which water is used truck crops

(Domestic, irrigation, municipal, manufacturing, industrial, etc.)

6. Description of Well: Depth 30 feet. Type drilled

diameter 5 inches. Elevation of ground at well site 226 feet, mean sea level.
(Dug or drilled) (As near as known)

Depth to water table 14 feet.

7. Capacity of Well: 225 g.p.m. with 1 feet drawdown.

_____ g.p.m. with _____ feet drawdown.

Date before 1945

If _____ well: Measured discharge _____ g.p.m. on _____
(Date)

Shut-off pressure at ground surface _____ lbs. per sq. in. on _____
(Date)

Water is controlled by _____
(Cap, valve, etc.)

8. Casing: (Give diameter, commercial specifications and depth below ground surface of each casing size.)

5 inch diameter steel from surface to 32 feet
 inch diameter from to feet
 inch diameter from to feet
 inch diameter from to feet

Describe and show depth of shoe, plug, adapter, liner or other details:

9. Perforated Casings or Screens:

unknown from to
(Number per foot and size of perforations, or describe screen)
 from to
 from to
 from to

10. Log of Well: (Describe each stratum or formation clearly, indicate if water bearing, and give thickness and depth as indicated.)

MATERIAL	Thickness (Feet)	Depth to Bottom (Feet)
unknown		

If log of well is not available, give name and address of driller.

11. Infiltration Trench: Covered or open

Dimensions: Length ft. Minimum depth ft. Maximum depth ft.

Bottom width ft. Discharge g.p.m. Date of test

12. Tunnel: Type of lining

Dimensions:
(Length, course, and cross sectional size)

Position of water bearing stratum with reference to portal of tunnel

Log of tunnel: (Preceding table for log of well may be used, if desired. Give footage from portal and character of materials, as pertinent.)

13. Pumping Equipment:

(a) Pump Gould centrifugal Capacity 100 g.p.m.
(Make, type and size)


(b) Motor 5 h.p. single phase electric
(Type and horsepower)

14. Location of area irrigated or to be irrigated, or place of use if for purposes other than irrigation.

Township North or South	Range E. or W. of Willamette Meridian	Section	Forty-acre Tract	Number Acres To Be Irrigated	Date of Reclamation
11 S	4 W	30	NW ¹ NW ²	10.9	
11 S	4 W	30	NE ¹ NW ²	4.6	
11 S	4 W	19	SW ¹ SW ²	1.7	
11 S	4 W	19	SE ¹ SW ²	1.2	
				17.4	

15. If the ground water supply is supplemental to an existing water supply, identification of any application for a permit, permit, certificate or adjudicated right to appropriate water made or held by the registrant.

Township 11 S Range 4 E, W.M.
North

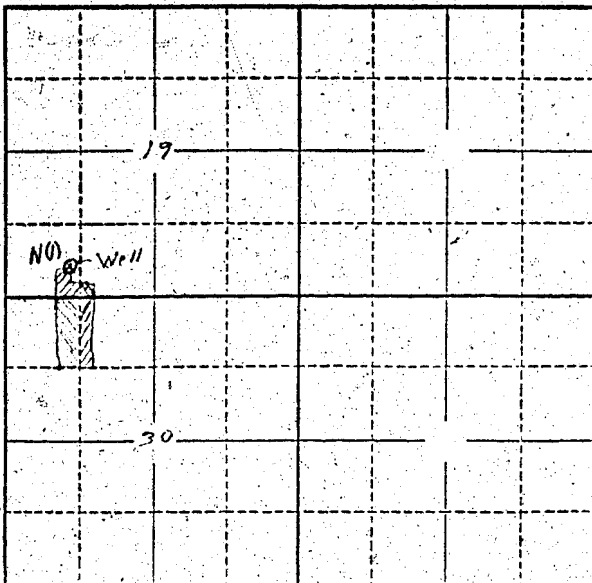

Locate well and acreage of irrigated land on plat.

Scale: 2" = 1 Mile

STATE OF OREGON

County of BENTON } ss.

I, GLYDE S. MILLSAP, being first duly sworn, do hereby certify that I have read the foregoing Registration Statement and that all of the items therein contained are true to the best of my knowledge and belief.

Glyde S. Millsap
(Signature of Registrant)

Subscribed and sworn to before me this 6th day of November, 1957

My commission expires PUBLIC
(SEAL) My Commission Expires and Expires, 1960

Ann J. Hunt
(Notary Public)

CERTIFICATE OF REGISTRATION

STATE OF OREGON }
County of Marion } ss.

This is to certify that the foregoing Registration Statement was received in the office of the State Engineer on the 11th day of November, 1957, at 1:00 o'clock P. M. and has been duly recorded in said office in Book No. 4 of Registration Statements on page GR-696 C.

Witness my hand this 21st day of January, 1958.

Laura A. Stanley
(State Engineer)

By _____ (Deputy)