

Registration Statement

REGISTRATION NO. GR-717

CERTIFICATE NO. GR-667

OF CLAIMANT OF RIGHT TO APPROPRIATE GROUND WATER

(Under Chapter 708, Oregon Laws 1955.)

TO THE STATE ENGINEER OF OREGON:

I, Jack Robert Chapin
of Marion Dist 2, Box 206 County of Marion
State of Oregon do hereby make application for a certificate of registration as evidence
of a right to appropriate ground water.

1. Source from which water is withdrawn is pump well #1 South collards well
(Flowing well, pump well, infiltration trench, or tunnel)

2. Location is: 10 miles north of Salem
(Approximate distance and direction from nearest city or town)

and is more particularly described as follows:

(a) 990 ft east + 990 ft north of Section corner 14, 11, 14, & 15
(Give distance and bearing to corner of section or other legal subdivision)

being within S1/4 SW1/4 of Sec. 11 Twp. 6 S Rge. 3 W
(Smallest legal subdivision) (N. or S.) (E. or W.)

or (b) within limits of recorded platted property, town or city:

Lot _____ Block _____ of _____
(Name of plat or addition)

County of _____
(If within city or town, give name)

3. Construction Work was begun on about 1930 : was completed on 1930
(Date) (Date)

and the ground water claimed was first used for the purposes set out below on 1930
(Date)

since which time the water has been used continuously
(Continuously or intermittently)

from April to December
(Date) (Date)

4. Quantity of water claimed and used is 150 gallons per minute; _____ acre
feet per year.

5. Purpose or Purposes for which water is used irrigation and domestic

(Domestic, irrigation, municipal, manufacturing, industrial, etc.)

6. Description of Well: Depth 70 feet. Type drilled
(Dug or drilled)

diameter _____ inches. Elevation of ground at well site 115' feet, mean sea level.
(As near as known)

Depth to water table 10 feet.

7. Capacity of Well: _____ g.p.m. with _____ feet drawdown.

more than 100 g.p.m. with _____ feet drawdown.

Date of test March 4

If Flowing Well: Measured discharge _____ g.p.m. on _____ (Date)

Shut-in pressure at ground surface _____ lbs. per sq. in. on _____ (Date)

Water is controlled by _____
(Cap, valve, etc.)

8. Casing: (Give diameter, commercial specifications and depth below ground surface of each casing size.)

8 inch diameter from to feet
 inch diameter from to feet
 inch diameter from to feet
 inch diameter from to feet

Describe and show depth of shoe, plug, adapter, liner or other details:

9. Perforated Casings or Screens:

from to
 (Number per foot and size of perforations, or describe screen)
 from to
 from to
 from to

10. Log of Well: (Describe each stratum or formation clearly, indicate if water bearing, and give thickness and depth as indicated.)

MATERIAL	Thickness (Feet)	Depth to Bottom (Feet)
I have not been able to find who drilled this well. My father called him. It drilled about 1920. My father is deceased and my mother told me she thought. My father said she was wrong. My father says he didn't and doesn't know who did.		
My father told me that well is 45 ft deep.		
It is a sand well. It will supply water better than any other well in the neighborhood. It is drilled with the double line system.		

If log of well is not available, give name and address of driller.....

11. Infiltration Trench: Covered or open

Dimensions: Length ft. Minimum depth ft. Maximum depth ft.

Bottom width ft. Discharge g.p.m. Date of test

12. Tunnel: Type of lining

Dimensions:
(Length, course, and cross sectional size)

Position of water bearing stratum with reference to portal of tunnel

Log of tunnel: (Preceding table for log of well may be used, if desired. Give footage from portal and character of materials, as pertinent.)

13. Pumping Equipment:

(a) Pump Pacific Centrifugal Capacity g.p.m.
(Make, type and size)

(b) Motor 30 H.P. Electric Motor
(Type and horsepower)

14. Location of area irrigated or to be irrigated, or place of use if for purposes other than irrigation.


Township North or South	Range E. or W. of Williamsite Meridian	Section	Forty-acre Tract	Number Acres To Be Irrigated	Date of Reclamation
6 S	3 W	14	20		
		11	115		
		10	16		
				145	
6 S	3 W	11	NW 1/4 of SW 1/4	20	1930
"	"	11	NE 1/4 of SW 1/4	18	"
"	"	11	SW 1/4 of SW 1/4	39	"
"	"	11	SE 1/4 of SW 1/4	38	"
"	"	10	NE 1/4 of SE 1/4	8	"
"	"	10	SE 1/4 of SE 1/4	2	"
"	"	14	NW 1/4 of NW 1/4	18	"
"	"	14	NE 1/4 of NW 1/4	2	"
				145	"

15. If the ground water supply is supplemental to an existing water supply, identification of any application for a permit, permit, certificate or adjudicated right to appropriate water made or held by the registrant.

I have a water right to irrigate part of the same area from a lake and am registering another well for most of this same area. I use what is the most convenient.

GR-667 B

North

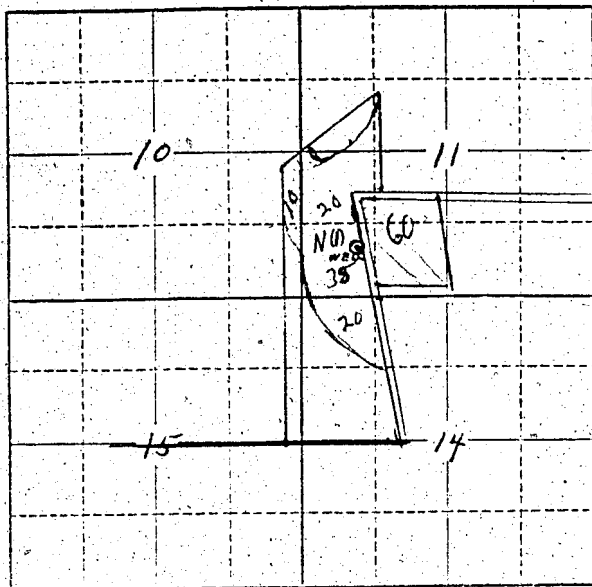

Scale: 2" = 1 Mile

County of Marion

Jack R. Chapin
(Signature of Registrant)

My commission expires June 12th 1961

Wm. S. Bartholomew
(Notary Public)

(SEAL)

CERTIFICATE OF REGISTRATION

County of Marion

Construction shall be completed by x-x-x-x-x-x-x-x-x-x, 19x-x, and the water completely applied to x


Witness my hand this 2nd day of January

1958
Lewis A. Stanley
(State Engineer)

By

(Deputy)

GR-667 C