

RECEIVED
NOV 18 1957
STATE ENGINEER
SALEM, OREGON

REGISTRATION NO. 84-221
CERTIFICATE NO. GR-697

Registration Statement

OF CLAIMANT OF RIGHT TO APPROPRIATE GROUND WATER

(Under Chapter 708, Oregon Laws 1955.)

TO THE STATE ENGINEER OF OREGON:

I, Wayne W. McBee
of Rt. 4, Box 119, Eugene County of Lane
State of Oregon, do hereby make application for a certificate of registration as evidence
of a right to appropriate ground water.

1. Source from which water is withdrawn is Pump Well #1
(Flowing well, pump well, infiltration trench, or tunnel)

2. Location is: Two miles Northeast of Goshen, Oregon
(Approximate distance and direction from nearest city or town)

and is more particularly described as follows:

(a) 1287' East & 720' North of the SW corner of the SW 1/4 - SE 1/4
(Give distance and bearing to corner of section or other legal subdivision)

being within SW 1/4 - SE 1/4 of Sec. 12, Twp. 18 S, Rge. 3 W
(Smallest legal subdivision) (N. or S.) (E. or W.)

or (b) within limits of recorded platted property, town or city:

in Lot _____, Block _____ of _____
(Name of plat or addition)

County of _____
(If within city or town, give name)

3. Construction Work was begun on June 1930; was completed on June 1930
(Date) (Date)

and the ground water claimed was first used for the purposes set out below on July 1930
(Date)

since which time the water has been used Continuously
(Continuously or intermittently)

from July 1930 to Present
(Date) (Date)

4. Quantity of water claimed and used is 300 gallons per minute; 116 acre
feet per year.

5. Purpose or Purposes for which water is used Irrigation

(Domestic, irrigation, municipal, manufacturing, industrial, etc.)

6. Description of Well: Depth 18 feet. Type Dug
(Dug or drilled)

diameter 4' x 6' inches. Elevation of ground at well site 460 feet, mean sea level.
(As near as known)

Depth to water table 12 feet.

7. Capacity of Well: Not Known g.p.m. with _____ feet drawdown.

Not Known g.p.m. with _____ feet drawdown.


Date of test _____

If Flowing Well: Measured discharge _____ g.p.m. on _____
(Date)

Shut-in pressure at ground surface _____ lbs. per sq. in. on _____
(Date)

Water is controlled by _____
(Cap, valve, etc.)

Township 185 Range 34 W.M.
North

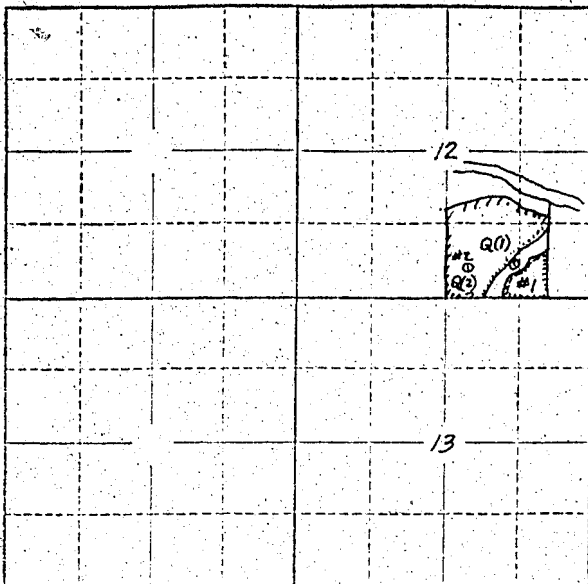

Locate well and acreage of irrigated land on plat.

Scale: 2" = 1 Mile

STATE OF OREGON

County of Linn

ss.

I, Wagner W. McBee, being first duly sworn, do hereby certify that I have read the foregoing Registration Statement and that all of the items therein contained are true to the best of my knowledge and belief.

Wagner W. McBee
(Signature of Registrant)

Subscribed and sworn to before me this 27th day of November, 1957

My commission expires Apr. 12, 1961

R. H. Bowers
(Notary Public)

(SEAL)

CERTIFICATE OF REGISTRATION

STATE OF OREGON

County of Marion

ss.

This is to certify that the foregoing Registration Statement was received in the office of the State Engineer on the 18th day of November, 1957, at 8:00 o'clock A. M. and has been duly recorded in said office in Book No. 4 of Registration Statements on page 65-697 C

~~Construction shall be completed by 1958 and the water completely applied to beneficial use by 1958~~

Witness my hand this 21st day of January, 1958

Lewis A. Stanley
(State Engineer)

By _____ (Deputy)

GR-697 C

#1755