RECEIVED
NOV 18 1957
STATE ENGINEER
SALEM, OREGON

REGISTRATION NO. GR-232

Registration Statement CERTIFICATE NO. GR-698

OF CLAIMANT OF RIGHT TO APPROPRIATE GROUND WATER

(Under Chapter 708, Oregon Laws 1955.)

TO THE STATE ENGINEER OF OREGON:

I, Wayne W. McBee,

of Rt. 4, Box 119, Eugene County of Lane

State of Oregon, do hereby make application for a certificate of registration as evidence of a right to appropriate ground water.

1. **Source** from which water is withdrawn is Pump Well #2
(Flowing well, pump well, infiltration trench, or tunnel)

2. **Location** is: Two miles Northeast of Goshen, Oregon;
(Approximate distance and direction from nearest city or town)

and is more particularly described as follows:

(a) 520' East & 617' North of the SW corner of the SW¼ - SE¼
(Give distance and bearing to corner of section or other legal subdivision)

being within SW¼ - SE¼ (Smallest legal subdivision) of Sec. 12, Twp. 18s (N. or S.), Rge. 3W (E. or W.)

or (b) within limits of recorded platted property, town or city:

in Lot ....., Block ..... of ..... (Name of plat or addition)

..... County of .....
(If within city or town, give name)

3. **Construction Work** was begun on June 1938 (Date); was completed on June 1938 (Date)

and the ground water claimed was first used for the purposes set out below on July 1938 (Date),

since which time the water has been used Intermittently (Continuously or intermittently)

from July 1938 (Date) to Present (Date)

4. **Quantity** of water claimed and used is 192 gallons per minute; 41 acre feet per year.

5. **Purpose or Purposes** for which water is used Irrigation
(Domestic, irrigation, municipal, manufacturing, industrial, etc.)

6. **Description of Well:** Depth 17 feet. Type Dug (Dug or drilled)

diameter 3 ~~inches~~ feet. Elevation of ground at well site 460 (As near as known) feet, mean sea level.

Depth to water table 12 feet.

7. **Capacity of Well:** ..... g.p.m. with ..... feet drawdown.
Not Known g.p.m. with ..... feet drawdown.

Date of test .....

If Flowing Well: Measured discharge ..... g.p.m. on ..... (Date)

Shut-in pressure at ground surface ..... lbs. per sq. in. on ..... (Date)

Water is controlled by ..... (Cap, valve, etc.)

8. **Casing:** (Give diameter, commercial specifications and depth below ground surface of each casing size.)

..... inch diameter None at present ..... from ..... to ..... feet

..... inch diameter ..... from ..... to ..... feet

..... inch diameter ..... from ..... to ..... feet

..... inch diameter ..... from ..... to ..... feet

Describe and show depth of shoe, plug, adapter, liner or other details: .....

None

9. **Perforated Casings or Screens:**

None ..... from ..... to .....
(Number per foot and size of perforations, or describe screen)

..... from ..... to .....

..... from ..... to .....

..... from ..... to .....

10. **Log of Well:** (Describe each stratum or formation clearly, indicate if water bearing, and give thickness and depth as indicated.)

MATERIAL	Thickness (Feet)	Depth to Bottom (Feet)
Soil	10'	
Gravel	7' plus	

GR-698 A

If log of well is not available, give name and address of driller. .....

.....

11. **Infiltration Trench:** Covered or open .....

Dimensions: Length ..... ft. Minimum depth ..... ft. Maximum depth ..... ft.

Bottom width ..... ft. **Discharge** ..... g.p.m. Date of test .....

12. **Tunnel:** Type of lining .....

Dimensions: .....
(Length, course, and cross sectional size)

Position of water bearing stratum with reference to portal of tunnel .....

.....

Log of tunnel: (Preceding table for log of well may be used, if desired. Give footage from portal and character of materials, as pertinent.)

13. **Pumping Equipment:**

(a) Pump Demming 1½ Cent. (Make, type and size) Capacity 200 g.p.m.

(b) Motor Model "A" gas engine 15 HP (Type and horsepower)

14. Location of area irrigated or to be irrigated, or place of use if for purposes other than irrigation.

Township North or South	Range E. or W. of Willamette Meridian	Section	Forty-acre Tract	Number Acres To Be Irrigated	Date of Reclamation
18 S	3 W	12	SW¼-SE¼	9.6	1938
"	"	"	SW¼-SE¼	2.9	New
"	"	"	NW¼-SE¼	4.0	"
				16.5 Total	

15. If the ground water supply is supplemental to an existing water supply, identification of any application for a permit, permit, certificate or adjudicated right to appropriate water made or held by the registrant.

.....

.....

GR-693 B

Township 18S Range 3W, W.M.

North

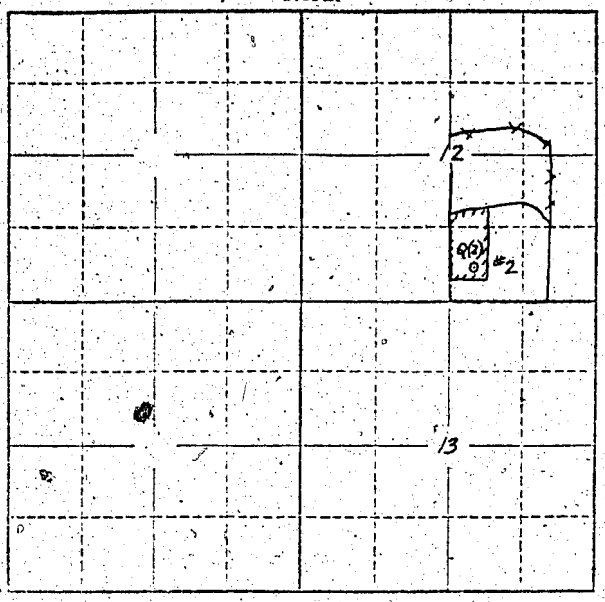

Locate well and acreage of irrigated land on plat.

Scale: 2" = 1 Mile

STATE OF OREGON
County of Lane } ss.

I, Wayne W. McBee, being first duly sworn, do hereby certify that I have read the foregoing Registration Statement and that all of the items therein contained are true to the best of my knowledge and belief.

Wayne W. McBee
(Signature of Registrant)

Subscribed and sworn to before me this 8th day of November, 19 57

My commission expires Apr. 12th 1961

R. F. Benson
(Notary Public)

(SEAL)

CERTIFICATE OF REGISTRATION

STATE OF OREGON
County of Marion } ss.

This is to certify that the foregoing Registration Statement was received in the office of the State Engineer on the 18th day of November, 19 57, at 8:00 o'clock A. M. and has been duly recorded in said office in Book No. 4 of Registration Statements on page GR-698 C

~~Construction shall be completed by xxxxxxxxxxxxxxxx 19xx and the water completely applied to beneficial use by xxxxxxxxxxxxxxxx 19xx~~

Witness my hand this 24th day of January, 19 58

Lewis A. Stanley
(State Engineer)

By
(Deputy)

GR-698 C