

Registration Statement

REGISTRATION NO. GR 724CERTIFICATE NO. GR-700

OF CLAIMANT OF RIGHT TO APPROPRIATE GROUND WATER

(Under Chapter 708, Oregon Laws 1955.)

TO THE STATE ENGINEER OF OREGON:

I, Ivan T. Lazaroff & Anna P. Lazaroff
2370 meadow Lane
 of Woodburn County of Oregon marion

State of Oregon, do hereby make application for a certificate of registration as evidence of a right to appropriate ground water.

- Source from which water is withdrawn is Pumped Well #1
(Flowing well, pump well, infiltration trench, or tunnel)
- Location is: 1 Mile East of Woodburn
(Approximate distance and direction from nearest city or town)

and is more particularly described as follows:

(a) 1500' E & 1200' N from SW Corner Section 9
(Give distance and bearing to corner of section or other legal subdivision)

being within SE 1/4 SW 1/4 of Sec. 9, Twp. S 5, Rge. 1W
(Smallest legal subdivision) (N. or S.) (E. or W.)

or (b) within limits of recorded platted property, town or city:

in Lot _____, Block _____ of _____
(Name of plat or addition)

County of _____
(If within city or town, give name)

- Construction Work was begun on Spring 1955, was completed on Spring 1955
(Date) (Date)

and the ground water claimed was first used for the purposes set out below on 1956
(Date)

since which time the water has been used INTERMITTENTLY
(Continuously or Intermittently)

from MAY to SEPTEMBER
(Date) (Date)

- Quantity of water claimed and used is 40 gallons per minute; _____ acre feet per year.

- Purpose or Purposes for which water is used IRRIGATION
(Domestic, irrigation, municipal, manufacturing, industrial, etc.)

- Description of Well: Depth 110 feet. Type DRILLED
(Dug or drilled)

diameter 5 inches. Elevation of ground at well site _____ feet, mean sea level.
(As near as known)

Depth to water table _____ feet.

- Capacity of Well: 40 g.p.m. with 20 feet drawdown.
 _____ g.p.m. with _____ feet drawdown.


Date of test _____

If Flowing Well: Measured discharge _____ g.p.m. on _____
(Date)

Shut-in pressure at ground surface _____ lbs. per sq. in. on _____
(Date)

Water is controlled by _____
(Cap. valve, etc.)

Township 5S Range 1W W.M.
North

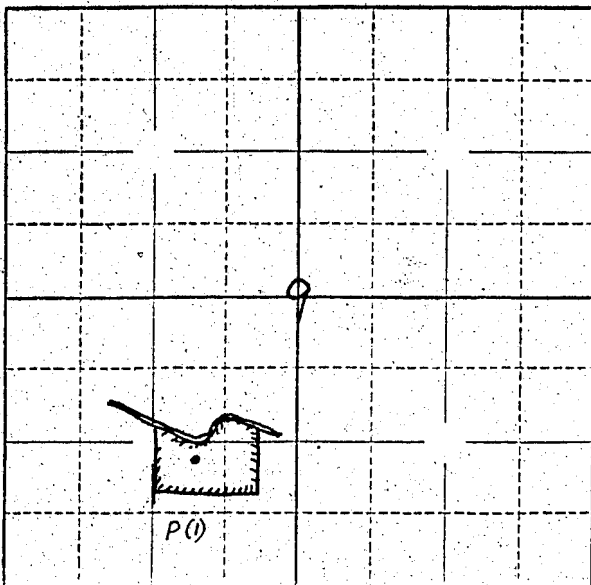

Locate well and acreage of irrigated land on plat.

Scale: $\frac{1}{4}$ " = 1 Mile

STATE OF OREGON

County of Marion

} ss.

I, _____, being first duly sworn, do hereby certify that I have read the foregoing Registration Statement and that all of the items therein contained are true to the best of my knowledge and belief.

Subscribed and sworn to before me this 19th day of November, 1957.

Ivan T. Lazaroff
Anna P. Lazaroff
(Signature of Registrant)

My commission expires June 12th, 1961

Wm. S. Bartholomew
(Notary Public)

(SEAL) STATE OF OREGON }
COUNTY OF MARION } -ss

Be it remembered, That on this above date—Nov 19, 1957, before me, the undersigned, A Notary Public in and for said County and State, personally appeared the within named Anna P. Lazaroff, wife of Ivan T. Lazaroff, and that she executed the above signature, freely and voluntarily.

NOTARY PUBLIC FOR OREGON **CERTIFICATE OF REGISTRATION**

My Commission expires—11/1/59

STATE OF OREGON

County of Marion

} ss.

This is to certify that the foregoing Registration Statement was received in the office of the State Engineer on the 19th day of November, 1957, at 8:00 o'clock A. M. and has been duly recorded in said office in Book No. 4 of Registration Statements on page GR-700.

~~Construction shall be completed by X-X-X-X-X-X-X-X-X-X, 19X-X, and the water completely applied to beneficial use by X-X-X-X-X-X-X-X-X-X, 19X-X-X~~

Witness my hand this 24th day of January, 1958

Lewis A. Stanley
(State Engineer)

By _____

(Deputy)

GR-700 C