

RECEIVED
NOV 20 1957

Registration Statement

STATE ENGINEER OF CLAIMANT OF RIGHT TO APPROPRIATE GROUND WATER
SALEM, OREGON

TO THE STATE ENGINEER OF OREGON:

I, Ebba N. Carothers

of 25755 S. W. Tualatin Valley Hwy, Hillsboro County of Washington

(Mailing address)

State of Oregon

do hereby make application for a certificate of registration as evidence of a right to appropriate ground water.

1. Source from which water is withdrawn is Pump well
(Flowing well, pump well, infiltration trench, or tunnel)

2. Location is: 2 1/2 miles north and east of Hillsboro on Evergreen Rd.
(Approximate distance and direction from nearest city or town)

and is more particularly described as follows:

(a) 500' East and 450' South of N. W. corner
(Give distance and bearing to corner of section or other legal subdivision)

being within S W 1/4 of S.E 1/4 of Sec. 20 Twp. 1 N Rge. 2 W.
(Smallest legal subdivision) (N. or S.) (E. or W.)

or (b) within limits of recorded platted property, town or city:

in Lot _____, Block _____ of _____
(Name of plat or addition)

County of _____

(If within city or town, give name)

3. Construction Work was begun on 4/52 ; was completed on 5 / 52
(Date) (Date)

and the ground water claimed was first used for the purposes set out below on 6/24/52
(Date)

since which time the water has been used continuously
(Continuously or Intermittently)

from 1952 to October 1957
(Date) (Date)

4. Quantity of water claimed and used is 90 gallons per minute; acre feet per year.

5. Purpose or Purposes for which water is used: Irrigation

(Domestic, irrigation, municipal, manufacturing, industrial, etc.)

6. Description of Well: Depth 45' feet. Type drilled
(Dug or drilled)

diameter 20 inches. Elevation of ground at well site 100 feet, mean sea level.
(As near as known)

Depth to water table 6 feet.

7. Capacity of Well: 90 g.p.m. with 30' feet drawdown.

g.p.m. with _____ feet drawdown.


Date of test May 1952

If Flowing Well: Measured discharge _____ g.p.m. on _____
(Date)

Shut-in pressure at ground surface _____ lbs. per sq. in. on _____
(Date)

Water is controlled by _____
(Cap. valve, etc.)

Township 1 N Range 2 W, W.M.
North

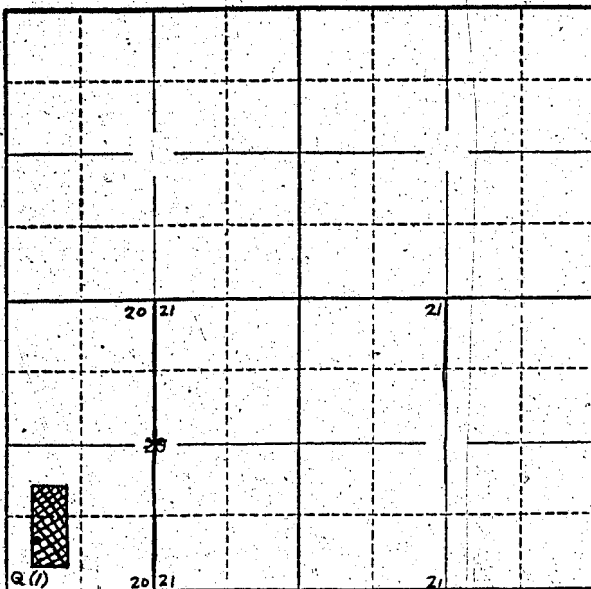

Locate well and acreage of irrigated land on plat.
Scale: 2" = 1 Mile

STATE OF OREGON

County of Washington } ss.

I, Elba N. Carothers, being first duly sworn, do hereby certify that I have read the foregoing Registration Statement and that all of the items therein contained are true to the best of my knowledge and belief.

Elba Carothers
(Signature of Registrant)

Subscribed and sworn to before me this 18th day of November, 1957

My commission expires MY COMMISSION EXPIRES MARCH 21, 1959

E. J. [Signature]
(Notary Public)

(SEAL)

CERTIFICATE OF REGISTRATION

STATE OF OREGON

County of Marion } ss.

This is to certify that the foregoing Registration Statement was received in the office of the State Engineer on the 20th day of November, 1957, at 8:00 o'clock A.M. and has been duly recorded in said office in Book No. 4 of Registration Statements on page GR-703 C.

Witness my hand this 21st day of January, 1958

Lewis A. Stanley
(State Engineer)

By _____
(Deputy)