REGISTRATION NO. GR-708

CERTIFICATE NO. GR-701

Registration Statement

OF CLAIMANT OF RIGHT TO APPROPRIATE GROUND WATER

(Under Chapter 708, Oregon Laws 1955.)

TO THE STATE ENGINEER OF OREGON:

I, S. E. Hansen,

of Route 3, Box 197, Medford County of Jackson

State of Oregon, do hereby make application for a certificate of registration as evidence of a right to appropriate ground water.

1. **Source** from which water is withdrawn is Infiltration trench
(Flowing well, pump well, infiltration trench, or tunnel)

2. **Location** is: 3 miles Southeast of Medford, Oregon
(Approximate distance and direction from nearest city or town)

and is more particularly described as follows:

(a) 1027 feet North and 1383 feet East from the SW corner DLC #56
(Give distance and bearing to corner of section or other legal subdivision)

being within SE¼ NE¼ of Sec. 34, Twp. 37 S. (N. or S.), Rge. 1 W. (E. or W.)
(Smallest legal subdivision)

or (b) within limits of recorded platted property, town or city:

in Lot ....., Block ..... of .....
(Name of plat or addition)

..... County of .....
(If within city or town, give name)

3. **Construction Work** was begun on October 18, 1952 (Date) was completed on October 29, 1952 (Date)

and the ground water claimed was first used for the purposes set out below on April 15, 1953 (Date),

since which time the water has been used continuously
(Continuously or intermittently)

from April 15, 1953 (Date) to October 1, 1957 (Date)

4. **Quantity** of water claimed and used is 108 gallons per minute; 87 acre feet per year.

5. **Purpose or Purposes** for which water is used irrigation
(Domestic, irrigation, municipal, manufacturing, industrial, etc.)

See Item 6. 6. **Description of Well:** Depth 20 feet. Type dug
(Dug or drilled)

diameter 29'x136' ~~inches~~. Elevation of ground at well site 1660 feet, mean sea level.
(As near as known)

Depth to water table 4.0 feet.

7. **Capacity of Well:** ..... g.p.m. with ..... feet drawdown.

..... g.p.m. with ..... feet drawdown.

Date of test none

If Flowing Well: Measured discharge ..... g.p.m. on .....
(Date)

Shut-in pressure at ground surface ..... lbs. per sq.-in. on .....
(Date)

Water is controlled by .....
(Cap, valve, etc.)

8. **Casing:** (Give diameter, commercial specifications and depth below ground surface of each casing size.)

..... inch diameter ....none.... from ..... to ..... feet

..... inch diameter ..... from ..... to ..... feet

..... inch diameter ..... from ..... to ..... feet

..... inch diameter ..... from ..... to ..... feet

Describe and show depth of shoe, plug, adapter, liner or other details: .....

.....

.....

9. **Perforated Casings or Screens:**

....none.... from ..... to .....
(Number per foot and size of perforations, or describe screen)

..... from ..... to .....

..... from ..... to .....

..... from ..... to .....

10. **Log of Well:** (Describe each stratum or formation clearly, indicate if water bearing, and give thickness and depth as indicated.)

MATERIAL	Thickness (Feet)	Depth to Bottom (Feet)
Heavy Black Clay	12	8
Rock and gravel (Water bearing lower 2 feet)	8	9

GR- 701 A

If log of well is not available, give name and address of driller. .....

11. **Infiltration Trench:** Covered or open ....open....

Dimensions: Length ....136.... ft. Minimum depth ....18.... ft. Maximum depth ....20.... ft.

Bottom width ....27.... ft. Discharge ..... g.p.m. Date of test ....none....

12. **Tunnel:** Type of lining .....

Dimensions: .....
(Length, course, and cross sectional size)

Position of water bearing stratum with reference to portal of tunnel .....

Log of tunnel: (Preceding table for log of well may be used, if desired. Give footage from portal and character of materials, as pertinent.)

13. **Pumping Equipment:**

(a) Pump ....Cornell 2½ inch centrifugal pump.... Capacity ....108.... g.p.m.
(Make, type and size)

(b) Motor ....7.5 H.P. electric motor.....
(Type and horsepower)

14. Location of area irrigated or to be irrigated, or place of use if for purposes other than irrigation.

Township North or South	Range E. or W. of Willamette Meridian	Section	Forty-acre Tract	Number Acres To Be Irrigated	Date of Reclamation
37 S.	1 W.	34	NE SE¼	1.8	April 15, 1953
		35	NW¼ SW¼	17.5	April 15, 1953
			Total	19.3 acres	

15. If the ground water supply is supplemental to an existing water supply, identification of any application for a permit, permit, certificate or adjudicated right to appropriate water made or held by the registrant.

none

GR-701 B

Township 37 S. Range 1 W., W.M.

North

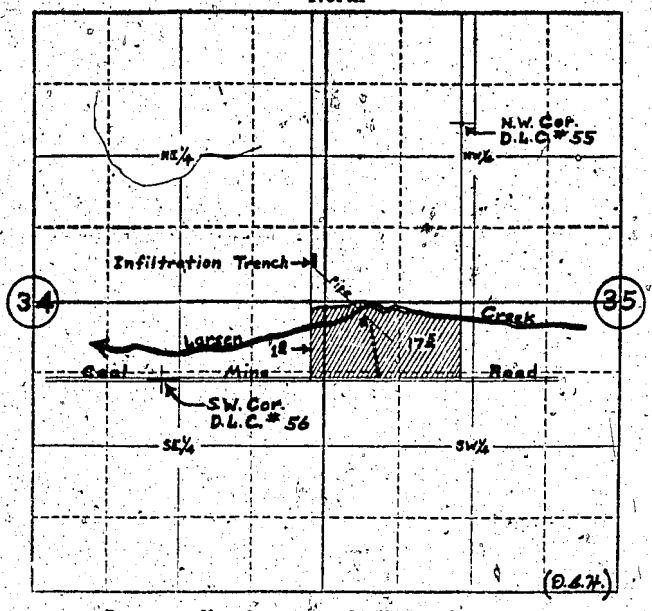

Locate well and acreage of irrigated land on plat.

Scale: 4" = 1 Mile

STATE OF OREGON
County of Jackson } ss.

I, E. E. Hansen, being first duly sworn, do hereby certify that I have read the foregoing Registration Statement and that all of the items therein contained are true to the best of my knowledge and belief.

E. E. Hansen
(Signature of Registrant)

Subscribed and sworn to before me this 19th day of November, 1957

My commission expires Nov. 23-1960 Leydak Tuin
(Notary Public) for Oregon

(SEAL)

CERTIFICATE OF REGISTRATION

STATE OF OREGON
County of Marion } ss.

This is to certify that the foregoing Registration Statement was received in the office of the State Engineer on the 20th day of November, 1957, at 1:00 o'clock P. M. and has been duly recorded in said office in Book No. 4 of Registration Statements on page GR-701 C

~~Construction shall be completed by x-x-x-x-x-x-x-x-x-19xx and the water completely applied to beneficial use by x-x-x-x-x-x-x-x-x-19xx~~

Witness my hand this 21th day of January, 1958

Lewis A. Stanley
(State Engineer)

By
(Deputy)

GR-701 C