

RECEIVED
NOV 9 1957
STATE ENGINEER
SALEM, OREGON

REGISTRATION NO. GR-730
CERTIFICATE NO. GR-705

Registration Statement

OF CLAIMANT OF RIGHT TO APPROPRIATE GROUND WATER

(Under Chapter 708, Oregon Laws 1955.)

TO THE STATE ENGINEER OF OREGON:

I, ROBERT ANDREW FIEDLER

of Salem County of Marion

State of Oregon, do hereby make application for a certificate of registration as evidence of a right to appropriate ground water.

1. Source from which water is withdrawn is Pump well #1
(Flowing well, pump well, infiltration trench, or tunnel)

2. Location is: 4745 Matter Drive, Salem, Oregon
(Approximate distance and direction from nearest city or town)

and is more particularly described as follows:

(a) 990 ft. East and 1000 ft. North from N.W. corner of HERRON D.L.C. 48
(Give distance and bearing to corner of section or other legal subdivision)

being within S.E. 1/4 of N.E. 1/4 of Sec. 7, Twp. South, Rge. 2 West
(Smallest legal subdivision) (N. or S.) (E. or W.)

or (b) within limits of recorded platted property, town or city:

in Lot _____, Block _____ of _____
(Name of plat or addition)

County of Marion

(If within city or town, give name)

3. Construction Work was begun on June 18, 1955; was completed on July 6, 1955
(Date) (Date)

and the ground water claimed was first used for the purposes set out below on July 24, 1955
(Date)

since which time the water has been used intermittently, continuously
(Continuously or intermittently)

from July 24, 1955 to Oct. 28, 1957
(Date) (Date)

4. Quantity of water claimed and used is 180 gallons per minute; 2 (two) acre feet per year.

5. Purpose or Purposes for which water is used Irrigation

(Domestic, irrigation, municipal, manufacturing, industrial, etc.)

6. Description of Well: Depth 133 feet. Type Drilled
(Dug or drilled)

diameter 10 inches. Elevation of ground at well site 665 220 feet, mean sea level.
(As near as known)

Depth to water table 21 feet.

7. Capacity of Well: 545 g.p.m. with 66 feet drawdown.

200 g.p.m. with 17 feet drawdown.

Date of test July 6, 1955


If Flowing Well: Measured discharge _____ g.p.m. on _____
(Date)

Shut-in pressure at ground surface _____ lbs. per sq. in. on _____
(Date)

Water is controlled by _____
(Cap, valve, etc.)

Township 7 S Range 2 W W.M.

North

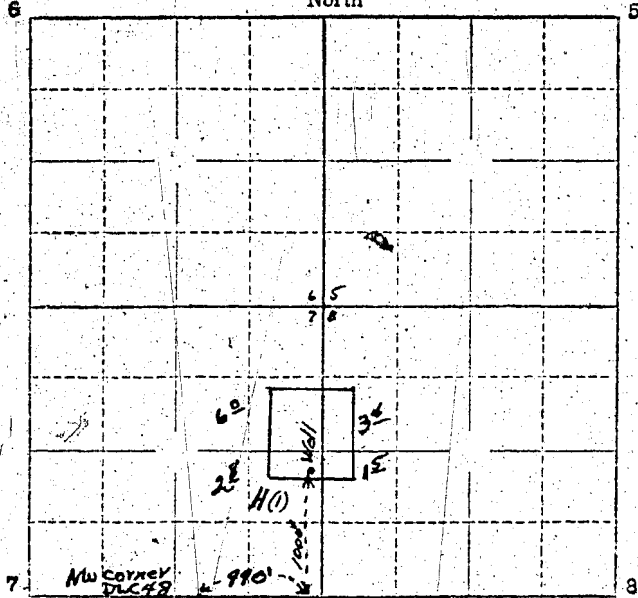

Locate well and acreage of irrigated land on plat.

Scale: 1" = 1 Mile

STATE OF OREGON

County of Marion } ss.

I, ROBERT ANDREW FIEDLER, being first duly sworn, do hereby certify that I have read the foregoing Registration Statement and that all of the items therein contained are true to the best of my knowledge and belief.

Robert A. Fiedler
(Signature of Registrant)

Subscribed and sworn to before me this 19th day of November, 1957

My commission expires 10/22/58 *Erinise M. Byers*
(Notary Public)

(SEAL)

CERTIFICATE OF REGISTRATION

STATE OF OREGON } ss.
County of Marion

This is to certify that the foregoing Registration Statement was received in the office of the State Engineer on the 19th day of November, 1957, at 4 o'clock P.M. and has been duly recorded in said office in Book No. 1 of Registration Statements on page GR-706 C

Construction shall be completed by 10-1-58 and the water completely applied to beneficial use by 10-1-58.

Witness my hand this 21th day of January, 1958
Laura A. Stanley
(State Engineer)

By _____ (Deputy) GR-706 C