

Registration Statement

STATE ENGINEER
SALEM, OREGON

OF CLAIMANT OF RIGHT TO APPROPRIATE GROUND WATER

(Under Chapter 708, Oregon Laws 1955.)

TO THE STATE ENGINEER OF OREGON:

I, J. H. Huber, Secretary-Treasurer of United Growers, Inc.of Salem County of MarionState of Oregon, do hereby make application for a certificate of registration as evidence of a right to appropriate ground water.

1. Source from which water is withdrawn is Pump well #1
(Flowing well, pump well, infiltration trench, or tunnel)
2. Location is: 2 miles south of Salem, Oregon
(Approximate distance and direction from nearest city or town)

and is more particularly described as follows:

- 1013.76' N15°-00'E, 204.25' S85°-06'E, 313.56' N8°-50'E,
(a) from the S.W. Corner of the J. R. Patterson D.L.C.
(Give distance and bearing to corner of section or other legal subdivision)

being within NW 1/4 SE 1/4 of Sec. 9, Twp. 8S, Rge. 3W
(Smallest legal subdivision) (N. or S.) (E. or W.)or (b) within limits of recorded platted property, town or city: Not applicablein Lot _____, Block _____ of _____
(Name of plat or addition)3 County of _____
(If within city or town, give name)

3. Construction Work was begun on
- sometime in 1933
- ; was completed on
- sometime in 1933
-
- (Date) (Date)

and the ground water claimed was first used for the purposes set out below on sometime in 1933
(Date)since which time the water has been used intermittently
(Continuously or Intermittently)from 1933 to date (1957)
(Date) (Date)

4. Quantity of water claimed and used is
- 40
- gallons per minute; _____ acre feet per year.

5. Purpose or Purposes for which water is used
- food processing
-
- (Domestic, irrigation, municipal, manufacturing, industrial, etc.)

6. Description of Well: Depth
- 67
- feet. Type
- drilled
-
- (Dug or drilled)

diameter 6 inches. Elevation of ground at well site 450 feet, mean sea level.
(As far as known)Depth to water table 20 feet.


7. Capacity of Well:
- 40
- g.p.m. with
- 23
- feet drawdown.

_____ g.p.m. with _____ feet drawdown.

Date of test shortly after well was completedIf Flowing Well: Measured discharge _____ g.p.m. on not applicable
(Date)Shut-in pressure at ground surface _____ lbs. per sq. in. on _____
(Date)Water is controlled by _____
(Cap, valve, etc.)

Township 8S Range 3W W.M.

North

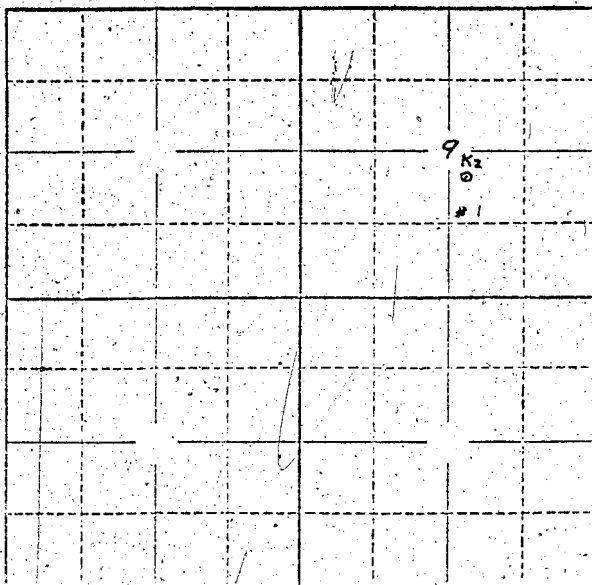

See map

Locate well and acreage of irrigated land on plat.

Scale: 2" = 1 Mile

STATE OF OREGON

County of Marion

ss.

I, F. H. Huber, being first duly sworn, do hereby certify that I have read the foregoing Registration Statement and that all of the items therein contained are true to the best of my knowledge and belief.

[Handwritten Signature]

(Signature of Registrant)

Subscribed and sworn to before me this 11th day of November, 1957

My commission expires June 15, 1960

[Handwritten Signature]

(Notary Public)

(SEAL)

CERTIFICATE OF REGISTRATION

STATE OF OREGON

County of Marion

ss.

This is to certify that the foregoing Registration Statement was received in the office of the State Engineer on the 21st day of November, 1957, at 8:00 o'clock A.M. and has been duly recorded in said office in Book No. 1 of Registration Statements on page GR-708 C

Construction shall be completed by 1958 and the water completely applied to beneficial use by 1959

Witness my hand this 24th day of January, 1958

[Handwritten Signature]

(State Engineer)

By

(Deputy)

GR-708 C