

RECEIVED
NOV 2 1957
STATE ENGINEER
SALEM, OREGON

REGISTRATION NO. GR-235

Registration Statement CERTIFICATE NO. GR-711

OF CLAIMANT OF RIGHT TO APPROPRIATE GROUND WATER

(Under Chapter 708, Oregon Laws 1955.)

TO THE STATE ENGINEER OF OREGON:

I, F. H. Huber, Secretary-Treasurer of United Growers, Inc.

of Salem County of Marion

State of Oregon, do hereby make application for a certificate of registration as evidence of a right to appropriate ground water.

1. Source from which water is withdrawn is pump well #4

(Flowing well, pump well, infiltration trench, or tunnel)

2. Location is: 2 miles south of Salem, Oregon

(Approximate distance and direction from nearest city or town)

and is more particularly described as follows:

1013.76' N150-00'E, 204.25' S85-06'E, 588.06' N8-50'E, 448.00' S74-17'E

(a) from the S.W. Corner of the J. R. Patterson D.L.C.

(Give distance and bearing to corner of section or other legal subdivision)

being within NW 1/4 SE 1/4

(Smallest legal subdivision)

of Sec. 9

Twp. 8S

Rge. 3W

(N. or S.)

(E. or W.)

or (b) within limits of recorded platted property, town or city: not applicable

in Lot _____, Block _____ of _____

(Name of plat or addition)

(If within city or town, give name)

County of _____

3. Construction Work was begun on sometime in 1945; was completed on sometime in 1945

(Date)

(Date)

and the ground water claimed was first used for the purposes set out below on sometime in 1945

(Date)

since which time the water has been used intermittently

(Continuously or Intermittently)

from 1945 to date (1957)

(Date)

(Date)

4. Quantity of water claimed and used is 60 gallons per minute; _____ acre feet per year.

5. Purpose or Purposes for which water is used food processing

(Domestic, irrigation, municipal, manufacturing, industrial, etc.)

6. Description of Well: Depth 120 feet. Type drilled

(Dug or drilled)

diameter 6 inches. Elevation of ground at well site 200 feet, mean sea level.

(As near as known)

Depth to water table 30 feet.

7. Capacity of Well: 60 g.p.m. with 45 feet drawdown.

_____ g.p.m. with _____ feet drawdown.

Date of test shortly after well was completed

If Flowing Well: Measured discharge _____ g.p.m. on not applicable

(Date)

Shut-in pressure at ground surface _____ lbs. per sq. in. on _____

(Date)

Water is controlled by _____

(Cap, valve, etc.)

6	inch diameter	standard pipe with $\frac{1}{2}$ " casings	from	0	to	80	feet
	inch diameter		from		to		feet
	inch diameter		from		to		feet
	inch diameter		from		to		feet

Describe and show depth of shoe, plug, adapter, liner or other details: Unknown

Unknown

(Number per foot and size of perforations, or describe screen)

from to

from _____ to _____

from to

from to

[illegible]

GR-711A

If log of well is not available, give name and address of driller. **West Well Drilling**

4120 Market Street Salem, Oregon

11. Infiltration Trench: Covered or open not applicable

Dimensions: Length ft. Minimum depth ft. Maximum depth ft.

Bottom width ft. Discharge g.p.m. Date of test

12. Tunnel: Type of lining not applicable

Dimensions: _____
(Length, course and cross sectional size)

Position of water bearing stratum with reference to portal of tunnel

Log of tunnel: (Preceding table for log of well may be used, if desired. Give footage from portal and character of materials, as pertinent.)

13. Pumping Equipment:

(a) Pump Turbine type 5HP Capacity 60 g.p.m.

(Make, type and size)

(b) Motor US Motor 3 phase 5HP

(Type and horsepower)

14. Location of area irrigated or to be irrigated, or place of use if for purposes other than irrigation.


[illegible]

15. If the ground water supply is supplemental to an existing water supply, identification of any application for a permit, permit, certificate or adjudicated right to appropriate water made or held by the registrant.

Not applicable

GR-711B

Township 8S Range 3W W.M.
North

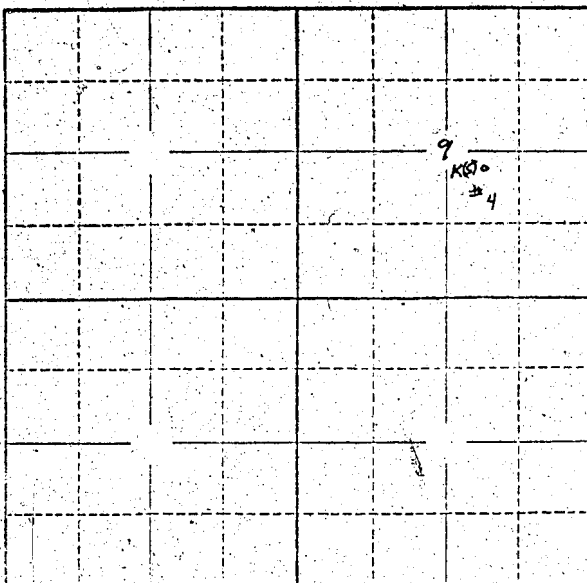

Locate well and acreage of irrigated land on plat.
Scale: 2" = 1 Mile

STATE OF OREGON

County of Marion } ss.

I, F. H. Huber, being first duly sworn, do hereby certify that I have read the foregoing Registration Statement and that all of the items therein contained are true to the best of my knowledge and belief.

[Signature]
(Signature of Registrant)

Subscribed and sworn to before me this 14th day of November, 1957.

My commission expires January 15, 1960

[Signature]
(Notary Public)

(SEAL)

CERTIFICATE OF REGISTRATION

STATE OF OREGON

County of Marion } ss.

This is to certify that the foregoing Registration Statement was received in the office of the State Engineer on the 21st day of November, 1957, at 8:00 o'clock A. M. and has been duly recorded in said office in Book No. 4 of Registration Statements on page GR-711 C.

Construction shall be completed by XXXXXX-XX-XX-19-XX and the water completely applied to beneficial use by XXXXXX-XX-XX-19-XX.

Witness my hand this 24th day of January, 1958.

[Signature]
(State Engineer)

By _____

(Deputy)

GR-711 C