RECEIVED
NOV 21 1957
STATE ENGINEER
SALEM, OREGON

REGISTRATION NO. GR 732

Registration Statement

CERTIFICATE NO. GR-713

OF CLAIMANT OF RIGHT TO APPROPRIATE GROUND WATER

(Under Chapter 708, Oregon Laws 1955.)

TO THE STATE ENGINEER OF OREGON:

I, F. H. Huber, Secretary-Treasurer of United Growers, Inc.,

of Salem County of Marion;

State of Oregon, do hereby make application for a certificate of registration as evidence of a right to appropriate ground water.

1. **Source** from which water is withdrawn is pump well #6
(Flowing well, pump well, infiltration trench, or tunnel)

2. **Location** is: 2 miles south of Salem, Oregon;
(Approximate distance and direction from nearest city or town)

and is more particularly described as follows:

(a) 1013.76' N15°-00'E, 204.25' S85°-06'E, 482.06' N8°-50'E, 255.00' S74°-17'E from S.W. Corner of the J. R. Patterson D.L.C.
(Give distance and bearing to corner of section or other legal subdivision)

being within NW 1/4 SE 1/4 (Smallest legal subdivision) of Sec. 9, Twp. 8S (N. or S.), Rge. 3W (E. or W.)

or (b) within limits of recorded platted property, town or city: not applicable

in Lot ....., Block ..... of ..... (Name of plat or addition)

..... (If within city or town, give name) County of .....

3. **Construction Work** was begun on sometime in 1947 (Date); was completed on sometime in 1947 (Date)

and the ground water claimed was first used for the purposes set out below on sometime in 1947 (Date),

since which time the water has been used continuously (Continuously or intermittently)

from 1947 (Date) to date (1957) (Date)

4. **Quantity** of water claimed and used is 375 gallons per minute; ..... acre feet per year.

5. **Purpose or Purposes** for which water is used food processing
(Domestic, irrigation, municipal, manufacturing, industrial, etc.)

6. **Description of Well:** Depth 602 feet. Type drilled (Dug or drilled)

diameter 10 inches. Elevation of ground at well site 200 (As near as known) feet, mean sea level.

Depth to water table 280 feet.

7. **Capacity of Well:** 375 g.p.m. with 20 feet drawdown.

..... g.p.m. with ..... feet drawdown.

Date of test shortly after well was completed

If Flowing Well: Measured discharge ..... g.p.m. on not applicable (Date)

Shut-in pressure at ground surface ..... lbs. per sq. in. on ..... (Date)

Water is controlled by ..... (Cap, valve, etc.)

8. **Casing:** (Give diameter, commercial specifications and depth below ground surface of each casing size.)

12 inch diameter standard pipe with ¼" casing from 0 to 267 feet

10 inch diameter standard pipe with ¼" casing from 0 to 400 feet
(10 in. pipe inside the 12 in. pipe)

..... inch diameter ..... from ..... to ..... feet

..... inch diameter ..... from ..... to ..... feet

Describe and show depth of shoe, plug, adapter, liner or other details: Unknown

9. **Perforated Casings or Screens:**

Unknown from ..... to .....
(Number per foot and size of perforations, or describe screen)

..... from ..... to .....

..... from ..... to .....

..... from ..... to .....

10. **Log of Well:** (Describe each stratum or formation clearly, indicate if water bearing, and give thickness and depth as indicated.)

MATERIAL	Thickness (Feet)	Depth to Bottom (Feet)
Unknown		

GR-713 A

If log of well is not available, give name and address of driller. Studebaker Bros.

Address unknown (somewhere in California)

11. **Infiltration Trench:** Covered or open not applicable

Dimensions: Length ..... ft. Minimum depth ..... ft. Maximum depth ..... ft.

Bottom width ..... ft. Discharge ..... g.p.m. Date of test .....

12. **Tunnel:** Type of lining not applicable

Dimensions: .....
(Length, course, and cross sectional size)

Position of water bearing stratum with reference to portal of tunnel .....

Log of tunnel: (Preceding table for log of well may be used, if desired. Give footage from portal and character of materials, as pertinent.)

13. **Pumping Equipment:**

(a) Pump turbine type 60HP (Make, type and size) Capacity 375 g.p.m.

(b) Motor US Motor 3 phase 60HP (Type and horsepower)

14. Location of area irrigated or to be irrigated, or place of use if for purposes other than irrigation.

Township North or South	Range E. or W. of Willamette Meridian	Section	Forty-acre Tract	Number Acres To Be Irrigated	Date of Reclamation
8S	3W	9	NW 1/4 SE 1/4 Used for food processing at 4715 Liberty Road Salem, Ore.		1947

15. If the ground water supply is supplemental to an existing water supply, identification of any application for a permit, permit, certificate or adjudicated right to appropriate water made or held by the registrant.

Not applicable

GR-713B

Township 8S Range 3W, W.M.

North

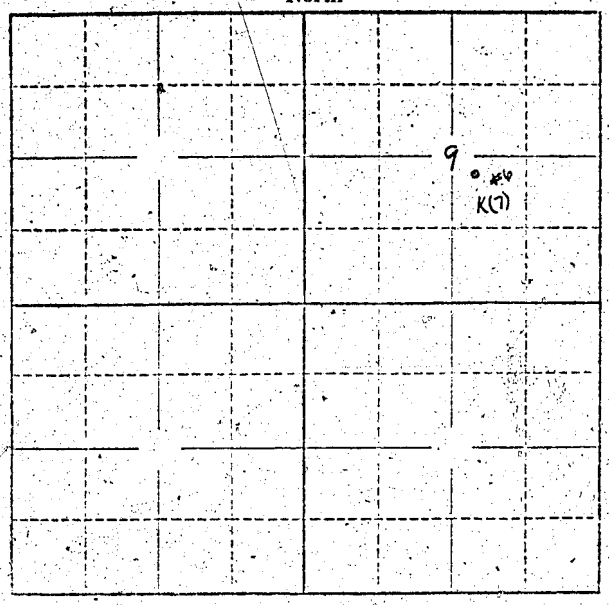

Locate well and acreage of irrigated land on plat.

Scale: 2" = 1 Mile

STATE OF OREGON
County of Marion } ss.

I, F. H. Huber, being first duly sworn, do hereby certify that I have read the foregoing Registration Statement and that all of the items therein contained are true to the best of my knowledge and belief.

(Signature of Registrant)

Subscribed and sworn to before me this [illegible] day of [illegible], 19[illegible]

My commission expires [illegible]

(Notary Public)

(SEAL)

CERTIFICATE OF REGISTRATION

STATE OF OREGON
County of Marion } ss.

This is to certify that the foregoing Registration Statement was received in the office of the State Engineer on the 21st day of November, 1957, at 8:00 o'clock A. M. and has been duly recorded in said office in Book No. 1 of Registration Statements on page GR-713 C.

~~Construction shall be completed by X-X-X-X-X-X-X-X-X-X, 19X-X-X and the water completely applied to beneficial use by X-X-X-X-X-X-X-X-X-X, 19X-X-X~~

Witness my hand this 24th day of January, 1958.

Lewis A. Stanley
(State Engineer)

By
(Deputy)

GR-713 C