

Registration Statement

REGISTRATION NO. GR-74
CERTIFICATE NO. GR-63

OF CLAIMANT OF RIGHT TO APPROPRIATE GROUND WATER

(Under Chapter 708, Oregon Laws 1955.)

TO THE STATE ENGINEER OF OREGON:

I, R. L. Simmons *vs Marie Simmons*
of Rt. 2, Box 204, Woodburn County of CLACKAMAS
State of OREGON, do hereby make application for a certificate of registration as evidence of a right to appropriate ground water.

- 1. Source from which water is withdrawn is Pump Well
(Flowing well, pump well, infiltration trench, or tunnel)
- 2. Location is: 1/4 mile East of Monitor
(Approximate distance and direction from nearest city or town)

and is more particularly described as follows:

(a) N 8° W, 855' 1/4 chains N & 3 chains W from SE Corner Sec. 30.
(Give distance and bearing to corner of section or other legal subdivision)
being within NE 1/4 SE 1/4 SE 1/4 of Sec. 30, Twp. 5S, Rge. 1E
(Smallest legal subdivision) (N. or S.) (E. or W.)

or (b) within limits of recorded platted property, town or city:
in Lot _____, Block _____ of _____
(Name of plat or addition)
County of CLACKAMAS
(If within city or town, give name)

3. Construction Work was begun on JUNE 1948; was completed on July 1948
(Date) (Date)
and the ground water claimed was first used for the purposes set out below on July 1948
(Date)
since which time the water has been used Continuously throughout the Summer months.
(Continuously or Intermittently)
from July 1948 to PRESENT
(Date) (Date)

4. Quantity of water claimed and used is 65 gallons per minute; 10 acre feet per year.

5. Purpose or Purposes for which water is used IRRIGATION
(Domestic, irrigation, municipal, manufacturing, industrial, etc.)

6. Description of Well: Depth 200 feet. Type DRILLED
(Dug or drilled)
diameter 6 inches. Elevation of ground at well site 220 feet, mean sea level.
(As near as known)
Depth to water table 70 feet.

7. Capacity of Well: 70 g.p.m. with 20 feet drawdown.
_____ g.p.m. with _____ feet drawdown.

Date of test July 1948

If Flowing Well: Measured discharge _____ g.p.m. on _____
(Date)

Shut-in pressure at ground surface _____ lbs. per sq. in. on _____
(Date)

Water is controlled by _____
(Cap, valve, etc.)

8. Casing: (Give diameter, commercial specifications and depth below ground surface of each casing size.)

6 inch diameter from GROUND to 190 feet
 inch diameter from to feet
 inch diameter from to feet
 inch diameter from to feet

Describe and show depth of shoe, plug, adapter, liner or other details:

9. Perforated Casings or Screens:

None from to
 (Number per foot and size of perforations, or describe screen)
 from to
 from to
 from to

10. Log of Well: (Describe each stratum or formation clearly, indicate if water bearing, and give thickness and depth as indicated.)

(SEE BELOW)

MATERIAL	Thickness (Feet)	Depth to Bottom (Feet)

If log of well is not available, give name and address of driller.

BYRON BALL WEBER - RT. 2 - WOODBURN, OREGON

11. Infiltration Trench: Covered or open

Dimensions: Length ft. Minimum depth ft. Maximum depth ft. Bottom width ft. Discharge g.p.m. Date of test

12. Tunnel: Type of lining

Dimensions: (Length, course, and cross sectional size) Position of water bearing stratum with reference to portal of tunnel

Log of tunnel: (Preceding table for log of well may be used, if desired. Give footage from portal and character of materials, as pertinent.)


13. Pumping Equipment:

(a) Pump COOK TURBINE 5 H.P. Capacity 70 g.p.m. (Make, type and size) (b) Motor U.S. - 5 H.P. - Single Phase (Type and horsepower)

14. Location of area irrigated or to be irrigated, or place of use if for purposes other than irrigation.

Table with 6 columns: Township North or South, Range E. or W. of Willamette Meridian, Section, Forty-acre Tract, Number Acres To Be Irrigated, Date of Reclamation. Handwritten entries include 5S, 1E, 30, SE 1/4 SE 1/4, 25, 5S, 1E, 30, NE 1/4 SE 1/4, 5.

15. If the ground water supply is supplemental to an existing water supply, identification of any application for a permit, certificate or adjudicated right to appropriate water made or held by the registrant.

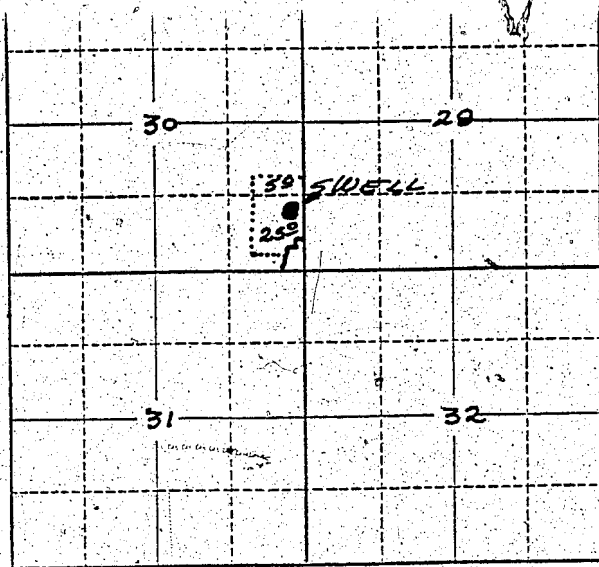

Locate well and acreage of irrigated land on plat.
Scale: 2" = 1 Mile

STATE OF OREGON

County of Clatsop } ss.

I, R. L. Simmons, being first duly sworn, do hereby certify that I have read the foregoing Registration Statement and that all of the items therein contained are true to the best of my knowledge and belief.

R. L. Simmons
(Signature of Registrant)

Subscribed and sworn to before me this 6th day of January, 1956.

My commission expires _____
(Notary Public)

(SEAL)

CERTIFICATE OF REGISTRATION

STATE OF OREGON

County of Marion } ss.

This is to certify that the foregoing Registration Statement was received in the office of the State Engineer on the 10th day of January, 1956, at 8:00 o'clock P. M. and has been duly recorded in said office in Book No. 1 of Registration Statements on page 63.

Construction ^{is} shall be completed by _____, 19____, and the water ^{is} completely applied to beneficial use by _____, 19____.

Witness my hand this 24th day of February, 1956.

Laura A. Stanley
(State Engineer)

By _____
(Deputy)