

RECEIVED
NOV 18 1957
STATE ENGINEER
SALEM, OREGON

Registration No. GR-712
Certificate No. GR-719

Registration Statement

OF CLAIMANT OF RIGHT TO APPROPRIATE GROUND WATER

TO THE STATE ENGINEER OF OREGON:

I, Rupert Edwards

of Junction City, Oregon, Route 2, County of Lane

State of Oregon, do hereby make application for a certificate of registration as evidence of right to appropriate ground water.

1. Source from which water is withdrawn is PUMP Well
(Flowing well, pump well, infiltration trench, or tunnel)
2. Location is: 3 miles SE of Junction City
(Approximate distance and direction from nearest city or town)

and is more particularly described as follows:

(a) 1954' South and 271' East from the NW corner of the NE 1/4 of Sec 9 T16N R4W
(Give distance and bearing to corner of section or other legal subdivision)

being within SW 1/4 of the NE 1/4 of Sec 9, Twp. 16 S, Rge. 4 W
(Smallest legal subdivision) (N. or S.) (E. or W.)

or (b) within limits of recorded platted property, town or city:

in Lot _____, Block _____ of _____
(Name of plat or addition)

County of _____
(If within city or town, give name)

3. Construction Work was begun on Aug 20, 1935; was completed on Aug 21, 1935
(Date) (Date)

and the ground water claimed was first used for the purposes set out below on 1935
(Date)

since which time the water has been used continuously
(Continuously or intermittently)

from 1935, Aug 21 to present
(Date) (Date)

4. Quantity of water claimed and used is 440 gallons per minute; 45 per acre
feet per year.

5. Purpose or Purposes for which water is used Irrigation of Walnuts & Silberts,
also of dill weed on that portion not in orchard.
(Domestic, irrigation, municipal, manufacturing, industrial, etc.)

6. Description of Well: Depth 28 feet. Type Driven
(Dug or drilled)

diameter 4 inches. Elevation of ground at well site 335 feet, mean sea level.
(As near as known)

Depth to water table 19' 6" ^{summed} feet.

7. Capacity of Well: 600 g.p.m. with 6 feet drawdown.

4 g.p.m. with _____ feet drawdown.


Date of test Aug 1949

If Flowing Well: Measured discharge _____ g.p.m. on _____
(Date)

Shut-in pressure at ground surface _____ lbs. per sq. in. on _____
(Date)

Water is controlled by _____
(Cap, valve, etc.)

Township 16S Range 4W, W.M.
North

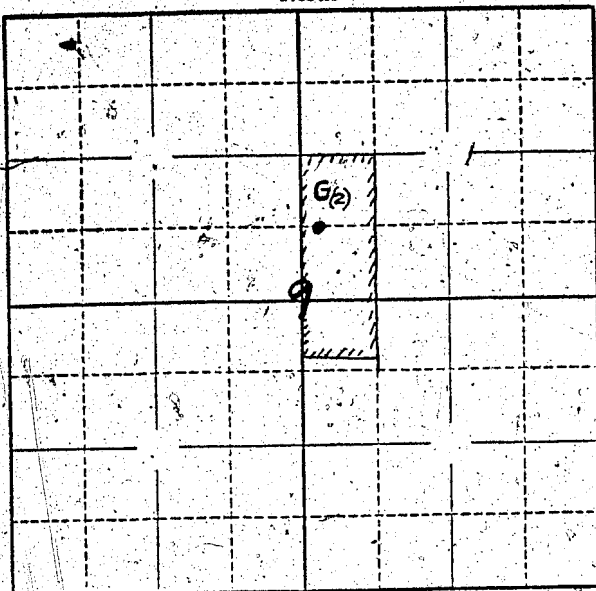

Locate well and acreage of irrigated land on plat.
Scale: 2" = 1 Mile

STATE OF OREGON }
County of Lane } ss.

I, Rupert Edwards, being first duly sworn, do hereby certify that I have read the foregoing Registration Statement and that all of the items therein contained are true to the best of my knowledge and belief.

Rupert Edwards
(Signature of Registrant)

Subscribed and sworn to before me this 14th day of November, 1957.

My commission expires March 13, 1961

David M. Van
(Notary Public)

(SEAL)

CERTIFICATE OF REGISTRATION

STATE OF OREGON }
County of Marion } ss.

This is to certify that the foregoing Registration Statement was received in the office of the State Engineer on the 26th day of November, 1957, at 8:00 o'clock A. M. and has been duly recorded in said office in Book No. 41 of Registration Statements on page GR-719 C.

Witness my hand this 24th day of January, 1958.

Lewis A. Stanley
(State Engineer)

By _____
(Deputy)