

RECEIVED  
NOV 18 1957  
STATE ENGINEER  
SALEM, OREGON

Registration No. GR-743

Certificate No. GR-720

# Registration Statement

## OF CLAIMANT OF RIGHT TO APPROPRIATE GROUND WATER

TO THE STATE ENGINEER OF OREGON:

I, Rupert Edwards

of Junction City, Oregon, Route 2 County of Lana

State of Oregon do hereby make application for a certificate of registration as evidence of a right to appropriate ground water.

1. Source from which water is withdrawn is DRIVEN PUMP WELL #2  
(Flowing well, pump well, infiltration trench, or tunnel)

2. Location is: 3 Miles South East of Junction City  
(Approximate distance and direction from nearest city or town)

and is more particularly described as follows:

(a) 1425' west and 201.5' south of the corner of the S.E. 1/4 of the NE 1/4 of Sec 9, Twp 15 S, R 4 W  
(Give distance and bearing to corner of section or other legal subdivision)

being within NW 1/4 of the SE 1/4 of Sec. 9, Twp. 16 S, Rge. 4 W  
(Smallest legal subdivision) (N. or S.) (E. or W.)

or (b) within limits of recorded platted property, town or city:

in Lot \_\_\_\_\_, Block \_\_\_\_\_ of \_\_\_\_\_  
(Name of plat or addition)

County of \_\_\_\_\_

(If within city or town, give name)

3. Construction Work was begun on July 2, 1945; was completed on July 2, 1945  
(Date) (Date)

and the ground water claimed was first used for the purposes set out below on July 3, 1945  
(Date)

since which time the water has been used Continuously  
(Continuously or Intermittently)

from July 3, 1945 to present  
(Date) (Date)

4. Quantity of water claimed and used is 440 gallons per minute; 75 acre feet per year. 25

5. Purpose or Purposes for which water is used Row crops, Orchard, Mint

Irrigation  
(Domestic, irrigation, municipal, manufacturing, industrial, etc.)

6. Description of Well: Depth 21 feet. Type Driven  
(Dug or drilled)

diameter 4 inches. Elevation of ground at well site 333 feet, mean sea level.  
(As near as known)

Depth to water table 12 feet.

7. Capacity of Well: 500 g.p.m. with 2 feet drawdown.

\_\_\_\_\_ g.p.m. with \_\_\_\_\_ feet drawdown.

Date of test July 1957

If Flowing Well: Measured discharge \_\_\_\_\_ g.p.m. on \_\_\_\_\_  
(Date)

Shut-in pressure at ground surface \_\_\_\_\_ lbs. per sq. in. on \_\_\_\_\_  
(Date)

Water is controlled by \_\_\_\_\_  
(Cap, valve, etc.)

8. Casing: (Give diameter, commercial specifications and depth below ground surface of each casing size.)

4 inch diameter from 0 to 21 feet  
 inch diameter from to feet  
 inch diameter from to feet  
 inch diameter from to feet

Describe and show depth of shoe, plug, adapter, liner or other details:

9. Perforated Casings or Screens:

5/16 Perforations 4 inches long in 4 rows 90° apart from 17 to 21  
(Number per foot and size of perforations, or describe screen)  
 from to  
 from to  
 from to

10. Log of Well: (Describe each stratum or formation clearly, indicate if water bearing, and give thickness and depth as indicated.)

MATERIAL	Thickness (Feet)	Depth to Bottom (Feet)
Silt clay loam	4	4
Mixed sand + assorted gravel	17	21

If log of well is not available, give name and address of driller.

11. Infiltration Trench: Covered or open

Dimensions: Length \_\_\_\_\_ ft. Minimum depth \_\_\_\_\_ ft. Maximum depth \_\_\_\_\_ ft.

Bottom width \_\_\_\_\_ ft. Discharge \_\_\_\_\_ g.p.m. Date of test \_\_\_\_\_

12. Tunnel: Type of lining

Dimensions: \_\_\_\_\_  
(Length, course, and cross sectional size)

Position of wafer bearing stratum with reference to portal of tunnel \_\_\_\_\_

Log of tunnel: (Preceding table for log of well may be used, if desired. Give footage from portal and character of materials, as pertinent.)

13. Pumping Equipment:

(a) Pump Pacific Centrifical 4X3 Capacity 500 g.p.m.  
(Make, type and size)


(b) Motor gasoline 28  
(Type and horsepower)

14. Location of area irrigated or to be irrigated, or place of use if for purposes other than irrigation.

Township North or South	Range E. or W. of Willamette Meridian	Section	Forty-acre Tract	Number Acres To Be Irrigated	Date of Reclamation
16S	4W	9	SW $\frac{1}{4}$ of the NE $\frac{1}{4}$ T9	6.12	
16S	4W	9	SE $\frac{1}{4}$ of the NE $\frac{1}{4}$ "	6.03	
16S	4W	9	NW $\frac{1}{4}$ of the SE $\frac{1}{4}$ T9	8.56	
16S	4W	9	NE $\frac{1}{4}$ of the SE $\frac{1}{4}$ "	8.85	

15. If the ground water supply is supplemental to an existing water supply, identification of any application for a permit, permit, certificate or adjudicated right to appropriate water made or held by the registrant.

Township 16S Range 4W W.M.  
North

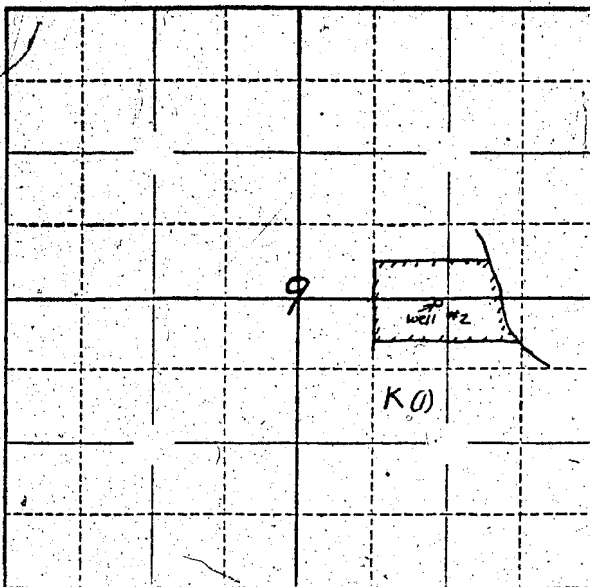

Locate well and acreage of irrigated land on plat.

Scale: 2" = 1 Mile

STATE OF OREGON

County of Tane } ss.

I, Rupert Edwards, being first duly sworn, do hereby certify that I have read the foregoing Registration Statement and that all of the items therein contained are true to the best of my knowledge and belief.

Rupert Edwards  
(Signature of Registrant)

Subscribed and sworn to before me this 14<sup>th</sup> day of November, 1957

My commission expires March 13 1961

Arthur M. Pass  
(Notary Public)

(SEAL)

**CERTIFICATE OF REGISTRATION**

STATE OF OREGON

County of Marion } ss.

This is to certify that the foregoing Registration Statement was received in the office of the State Engineer on the 26th day of November, 1957, at 6:00 o'clock A. M. and has been duly recorded in said office in Book No. 4 of Registration Statements on page GR-720 C.

Witness my hand this 24th day of January, 1958

Laura A. Stanley  
(State Engineer)

By \_\_\_\_\_  
(Deputy)

GR - 720 C