

Registration Statement

OF CLAIMANT OF RIGHT TO APPROPRIATE GROUND WATER

TO THE STATE ENGINEER OF OREGON:

I, O. D. Day and Vergia Day

of 85 Arnold Lane, Medford, Oregon County of Jackson

State of Oregon, do hereby make application for a certificate of registration as evidence of a right to appropriate ground water.

1. Source from which water is withdrawn is pump well #1
(Flowing well, pump well, infiltration trench, or tunnel)

2. Location is: 3 miles West of Medford, Oregon
(Approximate distance and direction from nearest city or town)

and is more particularly described as follows:

(a) 489 feet South and 163 feet East from the NW Cor. DLC #74
(Give distance and bearing to corner of section or other legal subdivision)

being within NW 1/4 SW 1/4 of Sec. 27, Twp. 37 S., Rge. 2 E.
(Smallest legal subdivision) (N. or S.) (E. or W.)

or (b) within limits of recorded platted property, town or city:

in Lot _____, Block _____ of _____
(Name of plat or addition)

County of _____
(If within city or town, give name)

3. Construction Work was begun on 1949; was completed on 1949
(Date) (Date)

and the ground water claimed was first used for the purposes set out below on 1949
(Date)

since which time the water has been used continuously
(Continuously or intermittently)

from 1949 to date
(Date) (Date)

4. Quantity of water claimed and used is 80 gallons per minute; 11 acre feet per year.

5. Purpose or Purposes for which water is used Irrigation

(Domestic, irrigation, municipal, manufacturing, industrial, etc.)

6. Description of Well: Depth 15 feet. Type Dug
(Dug or drilled)

diameter 10 inches. Elevation of ground at well site 1412 feet, mean sea level.
(As near as known)

Depth to water table 3.5 feet.

7. Capacity of Well: 80 g.p.m. with 4.0 feet drawdown.

_____ g.p.m. with _____ feet drawdown.


Date of test noted from use.

If Flowing Well: Measured discharge _____ g.p.m. on _____
(Date)

Shut-in pressure at ground surface _____ lbs. per sq. in. on _____
(Date)

Water is controlled by _____
(Cap, valve, etc.)

Township 37 S. Range 2 W., W.M.
North

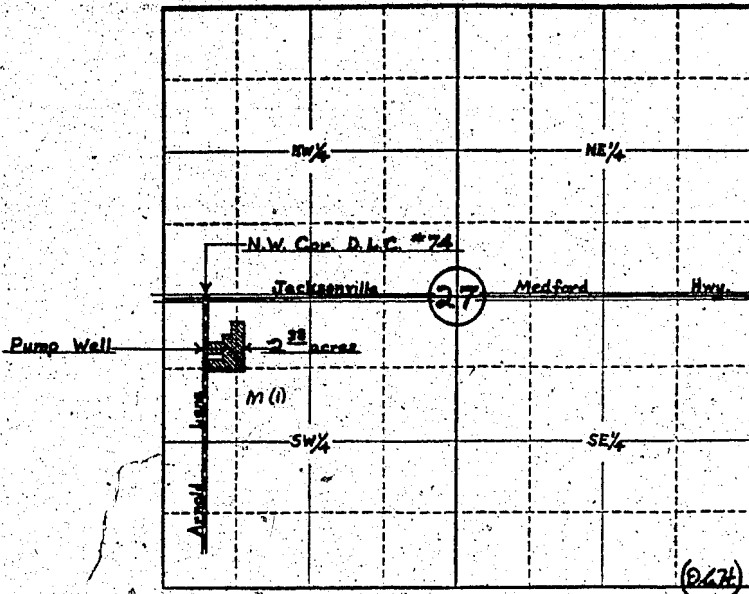

Locate well and acreage of irrigated land on plat.

Scale: **4"** = 1 Mile

STATE OF OREGON

County of JACKSON

} ss.

WE

O. D. DAY and VERGIA DAY, being first duly sworn, do hereby certify that I have read the foregoing Registration Statement and that all of the items therein contained are true to the best of my knowledge and belief.

O. D. Day
Vergia Day

(Signature of Registrant)

Subscribed and sworn to before me this 26th day of November, 19 57.

My commission expires Mar. 8, 1958

E. J. Martin

(Notary Public)

(SEAL)

CERTIFICATE OF REGISTRATION

STATE OF OREGON

County of Marion

} ss.

This is to certify that the foregoing Registration Statement was received in the office of the State Engineer on the 27th day of November, 1957, at 1:00 o'clock P. M. and has been duly recorded in said office in Book No. 4 of Registration Statements on page GR-723 C.

Witness my hand this 21th day of January, 19 58.

Laura A. Stanley

(State Engineer)

By

(Deputy)

GR-723 C