

# Registration Statement

## OF CLAIMANT OF RIGHT TO APPROPRIATE GROUND WATER

TO THE STATE ENGINEER OF OREGON:

I, Courtney G. Pursley

of R. 2, Box 30, Aurora, Ore. County of Clackamas

(Mailing address)

State of Oregon, do hereby make application for a certificate of registration as evidence of a right to appropriate ground water.

1. Source from which water is withdrawn is Dump well

(Flowing well, pump well, infiltration trench, or tunnel)

2. Location is: 1 1/2 miles east of Aurora

(Approximate distance and direction from nearest city or town)

and is more particularly described as follows: 2400 feet west and 475 feet north from SE corner Section 7,

(a) Approximately 1000 feet from the center of the south line

(Give distance and bearing to corner of section or other subdivision)

being within S.W. 1/4 of S.E. 1/4 of Sec. 7, Twp. 4 S., Rge. 1 E.W.

(Smallest legal subdivision)

(N. or S.)

(E. or W.)

or (b) within limits of recorded platted property, town or city:

in Lot \_\_\_\_\_, Block \_\_\_\_\_ of \_\_\_\_\_

(Name of plat or addition)

County of \_\_\_\_\_

(If within city or town, give name)

3. Construction Work was begun on January 1950; was completed on January 1950

(Date)

(Date)

and the ground water claimed was first used for the purposes set out below on June 1950

(Date)

since which time the water has been used Intermittently

(Continuously or intermittently)

from June 1950 to now

(Date)

(Date)

4. Quantity of water claimed and used is 175 gallons per minute; \_\_\_\_\_ acre feet per year.

5. Purpose or Purposes for which water is used Irrigation

(Domestic, irrigation, municipal, manufacturing, industrial, etc.)

6. Description of Well: Depth 118' et. Type drilled

(Dug or drilled)

diameter 8 inches. Elevation of ground at well site Approx. 145 feet, mean sea level.

(As near as known)

Depth to water table 56 feet.

7. Capacity of Well: 175 g.p.m. with 4.4 feet drawdown.

\_\_\_\_\_ g.p.m. with \_\_\_\_\_ feet drawdown.

Date of test May 1950

If Flowing Well: Measured discharge \_\_\_\_\_ g.p.m. on \_\_\_\_\_

(Date)

Shut-in pressure at ground surface \_\_\_\_\_ lbs. per sq. in. on \_\_\_\_\_

(Date)

Water is controlled by \_\_\_\_\_

(Cap, valve, etc.)

8. Casing: (Give diameter, commercial specifications and depth below ground surface of each casing size.)

8 inch diameter ..... from 0 to 118 feet  
 ..... inch diameter ..... from ..... to ..... feet  
 ..... inch diameter ..... from ..... to ..... feet  
 ..... inch diameter ..... from ..... to ..... feet

Describe and show depth of shoe, plug, adapter, liner or other details: .....

9. Perforated Casings or Screens:

4 rows of slots ..... from 75 to 117  
 (Number per foot and size of perforations, or describe screen)  
 ..... from ..... to .....  
 ..... from ..... to .....  
 ..... from ..... to .....

10. Log of Well: (Describe each stratum or formation clearly, indicate if water bearing, and give thickness and depth as indicated.)

MATERIAL	Thickness (Feet)	Depth to Bottom (Feet)
Sand and silt	56	56
Sand and gravel (brown)	12	68
Cement gravel	37	105
Blue clay	7	112
Sand and gravel	6	118

If log of well is not available, give name and address of driller. John Beck, Canby Ore.

11. Infiltration Trench: Covered or open .....

Dimensions: Length ..... ft. Minimum depth ..... ft. Maximum depth ..... ft.

Bottom width ..... ft. Discharge ..... g.p.m. Date of test .....

12. Tunnel: Type of lining .....

Dimensions: .....  
(Length, course, and cross sectional size)

Position of water bearing stratum with reference to portal of tunnel .....

Log of tunnel: (Preceding table for log of well may be used, if desired. Give footage from portal and character of materials, as pertinent.)

13. Pumping Equipment:

(a) Pump Peerless turbine 10 h.p. 5" outlet Capacity 200 g.p.m.  
(Make, type and size)


(b) Motor 10 h.p. U. S. Motor  
(Type and horsepower)

14. Location of area irrigated or to be irrigated, or place of use if for purposes other than irrigation.

Township North or South	Range E. or W. of Willamette Meridian	Section	Forty-acre Tract	Number Acres To Be Irrigated	Date of Reclamation
<u>4 S</u>	<u>1 E</u>	<u>7</u>	<u>SW 1/4 of SE 1/4</u>	<u>12</u>	<u>1950</u>

15. If the ground water supply is supplemental to an existing water supply, identification of any application for a permit, permit, certificate or adjudicated right to appropriate water made or held by the registrant.

Township 4 S Range 1 E W.M.  
North

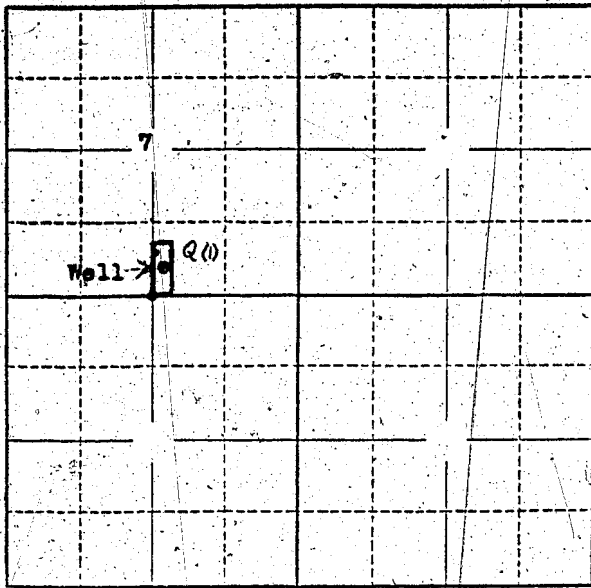

Locate well and acreage of irrigated land on plat.  
Scale: 2" = 1 Mile

STATE OF OREGON

County of

*Marion*

ss.

I, \_\_\_\_\_, being first duly sworn, do hereby certify that I have read the foregoing Registration Statement and that all of the items therein contained are true to the best of my knowledge and belief.

*B. Y. Pursley*  
(Signature of Registrar)

Subscribed and sworn to before me this *2nd* day of *December*, 19*57*.

My commission expires

*June 12, 1961*

*Wm. S. Bartholomew*  
(Notary Public)

(SEAL)

**CERTIFICATE OF REGISTRATION**

STATE OF OREGON

County of Marion

ss.

This is to certify that the foregoing Registration Statement was received in the office of the State Engineer on the *2nd* day of *December*, 19*57*, at *1:30* o'clock *P.*M. and has been duly recorded in said office in Book No. *4* of Registration Statements on page *GR-725 C*.

Witness my hand this *24th* day of *January*, 19*58*

*Lewis A. Stanley*  
(State Engineer)

By

(Deputy)