

Registration Statement

REGISTRATION NO. GR 752CERTIFICATE NO. GR-723

OF CLAIMANT OF RIGHT TO APPROPRIATE GROUND WATER

(Under Chapter 708, Oregon Laws 1955.)

TO THE STATE ENGINEER OF OREGON:

NE
4692 Swagle Rd., Salem, Ore

I, Reuben P. Imig + Myrna P. Imig
of ~~4692~~ Swagle Rd., Salem County of Marion
State of Oregon do hereby make application for a certificate of registration as evidence
of a right to appropriate ground water.

1. Source from which water is withdrawn is Pump Well
(Flowing well, pump well, infiltration trench, or tunnel)
2. Location is: 2 1/2 Miles East of Salem
(Approximate distance and direction from nearest city or town)

and is more particularly described as follows:

(a) 2350 feet north and 360 feet east from SW corner section 21
(Give distance and bearing to corner of section or other legal subdivision)

being within N 1/4 of SW 1/4 of Sec. 20 Twp. 7 S Rge. 2 W, WM
(Smallest legal subdivision) (N. or S.) (E. or W.)

or (b) within limits of recorded platted property, town or city:

in Lot _____ Block _____ of _____
(Name of plat or addition)

(If within city or town, give name) 1 County of Marion

3. Construction Work was begun on Nov 1952; was completed on Dec 4 1952
(Date) (Date)

and the ground water claimed was first used for the purposes set out below on May 1953
(Date)

since which time the water has been used Continuously during season
(Continuously or intermittently)

from 1953 to 1957
(Date) (Date)

4. Quantity of water claimed and used is 350 gallons per minute; _____ acre
feet per year.

5. Purpose or Purposes for which water is used Irrigation

(Domestic, irrigation, municipal, manufacturing, industrial, etc.)

6. Description of Well: Depth 120 feet. Type Drilled
(Dug or drilled)

diameter 8 inches. Elevation of ground at well site 130 feet, mean sea level.
(As near as known)

Depth to water table 20 feet.

7. Capacity of Well: 200 g.p.m. with 30 feet drawdown.
440 g.p.m. with 82 feet drawdown.

Date of test Dec 3 1952

If Flowing Well: Measured discharge _____ g.p.m. on _____ (Date)

Shut-in pressure at ground surface _____ lbs. per sq. in. on _____ (Date)

Water is controlled by _____
(Cap. valve, etc.)

8. Casing: (Give diameter, commercial specifications and depth below ground surface of each casing size.)

8 inch diameter Steel casing from TOP to 120 feet
inch diameter from to feet
inch diameter from to feet
inch diameter from to feet

Describe and show depth of shoe, plug, adapter, liner or other details:

9. Perforated Casings or Screens:

Yes - locations unknown from to
(Number per foot and size of perforations, or describe screen)
from to
from to
from to

10. Log of Well: (Describe each stratum or formation clearly, indicate if water bearing, and give thickness & depth as indicated.)

MATERIAL	Thickness (Feet)	Depth to Bottom (Feet)
<u>Gravel & sands</u>		

If log of well is not available, give name and address of driller. Marion West

11. Infiltration Trench: Covered or open

Dimensions: Length _____ ft. Minimum depth _____ ft. Maximum depth _____ ft.
Bottom width _____ ft. Discharge _____ g.p.m. Date of test _____

12. Tunnel: Type of lining

Dimensions: _____
(Length, course, and cross sectional size)
Position of water bearing stratum with reference to portal of tunnel _____

Log of tunnel: (Preceding table for log of well may be used, if desired. Give footage from portal and character of materials, as pertinent.)

13. Pumping Equipment:


(a) Pump Barkely - Turbine - 7 Stage Capacity 350 g.p.m.
(Make, type and size)
(b) Motor 3 Ph 20 HP
(Type and horsepower)

14. Location of area irrigated or to be irrigated, or place of use if for purposes other than irrigation.

Township North or South	Range E. or W. of Willamette Meridian	Section	Forty-acre Tract	Number Acres To Be Irrigated	Date of Reclamation
7S	2W	19	NE ¹ / ₄ of SE ¹ / ₄	9.0	May 1953
"	"	19	SE ¹ / ₄ of NE ¹ / ₄	2.0	" "
"	"	20	SW ¹ / ₄ of NW ¹ / ₄	6.0	" "
"	"	20	NW ¹ / ₄ of SW ¹ / ₄	18.0	" "
				350	" "

15. If the ground water supply is supplemental to an existing water supply, identification of any application for a permit, permit, certificate or adjudicated right to appropriate water made or held by the registrant.

Township 7 S Range 2 W W.M.
North

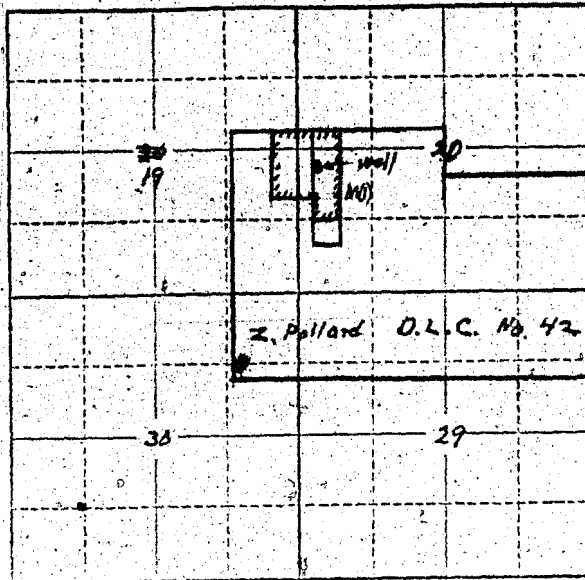

Locate well and acreage of irrigated land on plat.
Scale: 2" = 1 Mile

STATE OF OREGON

County of Marion

I, _____, being first duly sworn, do hereby certify that I have read the foregoing Registration Statement and that all of the items therein contained are true to the best of my knowledge and belief.

Arthur P. Lewis Myra R. Long
(Signature of Registrant)

Subscribed and sworn to before me this 3rd day of December 1957

My commission expires June 12th 1961 Wm. S. Bartholomew
(Notary Public)

(SEAL)

CERTIFICATE OF REGISTRATION

STATE OF OREGON

County of Marion

This is to certify that the foregoing Registration Statement was received in the office of the State Engineer on the 2nd day of December, 1957, at 8:00 o'clock A.M. and has been duly recorded in said office in Book No. 4 of Registration Statements on page 13-723 C.

~~Construction shall be completed by 12-31-58 and the water completely applied to beneficial use by 1-1-59.~~

Witness my hand this 21st day of January 1958

Lawrence A. Stansley
(State Engineer)

By _____ (Deputy)

GR-723 C