

## Registration Statement

## OF CLAIMANT OF RIGHT TO APPROPRIATE GROUND WATER

(Under Chapter 708, Oregon Laws 1955.)

TO THE STATE ENGINEER OF OREGON:

No. BURNS and ETHEL CHRISTOFFERSON, Husband and Wife  
 of 4420 Hood View Road, Salem County of Marion

State of Oregon, do hereby make application for a certificate of registration as evidence of a right to appropriate ground water.

1. Source from which water is withdrawn is Pump Well #2  
(Flowing well, pump well, infiltration trench, or tunnel)

2. Location is: 3 Miles Northeast of Salem  
(Approximate distance and direction from nearest city or town)

and is more particularly described as follows:

(a) S. 9.26 chains by 71.63 chains West of S.E. Corner of Sec. 32, T. 6S./  
(Give distance and bearing to corner of section or other legal subdivision)  
 being within N.W. 1/4 of NW 1/4 of Sec. 5, Twp. E. S., Rge. 2 W.  
(Smallest legal subdivision) (N. or S.) (E. or W.)

or (b) within limits of recorded platted property, town or city:

in Lot \_\_\_\_\_, Block \_\_\_\_\_ of \_\_\_\_\_  
(Name of plat or addition)

County of \_\_\_\_\_  
(If within city or town, give name)

3. Construction Work was begun on 1953; was completed on 1953  
(Date) (Date)

and the ground water claimed was first used for the purposes set out below on 1953  
(Date)

since which time the water has been used \_\_\_\_\_  
(Continuously or intermittently)

from 1953 to Present  
(Date) (Date)

4. Quantity of water claimed and used is 500 gallons per minute; 90 acre feet per year.

5. Purpose or Purposes for which water is used Irrigation

(Domestic, irrigation, municipal, manufacturing, industrial, etc.)

6. Description of Well: Depth 90 feet. Type Drilled  
(Dug or drilled)

diameter 8" inches. Elevation of ground at well site 178 feet, mean sea level.  
(As near as known)

Depth to water table 17 feet.

7. Capacity of Well: 500 g.p.m. with 20 feet drawdown.

\_\_\_\_\_ g.p.m. with \_\_\_\_\_ feet drawdown.

Date of test June 1, 1953

If Flowing Well: Measured discharge \_\_\_\_\_ g.p.m. on \_\_\_\_\_  
(Date)

Shut-in pressure at ground surface \_\_\_\_\_ lbs. per sq. in. on \_\_\_\_\_  
(Date)

Water is controlled by \_\_\_\_\_  
(Cap, valve, etc.)



If log of well is not available, give name and address of driller. ....

11. Infiltration Trench: Covered or open .....

Dimensions: Length ..... ft. Minimum depth ..... ft. Maximum depth ..... ft.

Bottom width ..... ft. Discharge ..... g.p.m. Date of test .....

12. Tunnel: Type of lining .....

Dimensions: .....  
(Length, course, and cross sectional size)

Position of water bearing stratum with reference to portal of tunnel .....

Log of tunnel: (Preceding table for log of well may be used, if desired. Give footage from portal and character of materials, as pertinent.)

13. Pumping Equipment:

(a) Pump Berkley Deep Well Capacity ..... g.p.m.  
(Make, type and size)

(b) Motor U.S. 10 H. P. 3 P.H. Electric  
(Type and horsepower)


14. Location of area irrigated or to be irrigated, or place of use if for purposes other than irrigation.

Township North or South	Range E. or W. of Willamette Meridian	Section	Forty-acre Tract	Number Acres To Be Irrigated	Date of Reclamation
6 S.	2 W.	32	SW $\frac{1}{4}$ SW $\frac{1}{4}$	5.2	1953
"	"	"	SE $\frac{1}{4}$ SW $\frac{1}{4}$	1.78	"
7	2 W.	5	NE $\frac{1}{4}$ NW $\frac{1}{4}$	1.47	"
"	"	"	NW $\frac{1}{4}$ NW $\frac{1}{4}$	10.70	"
				<u>19.15</u>	

Note: The above area is irrigated under a system of crop rotation. All of the area is not irrigated each year.

15. If the ground water supply is supplemental to an existing water supply, identification of any application for a permit, permit, certificate or adjudicated right to appropriate water made or held by the registrant.

Township 6+7 S Range 2 W, W.M.  
North

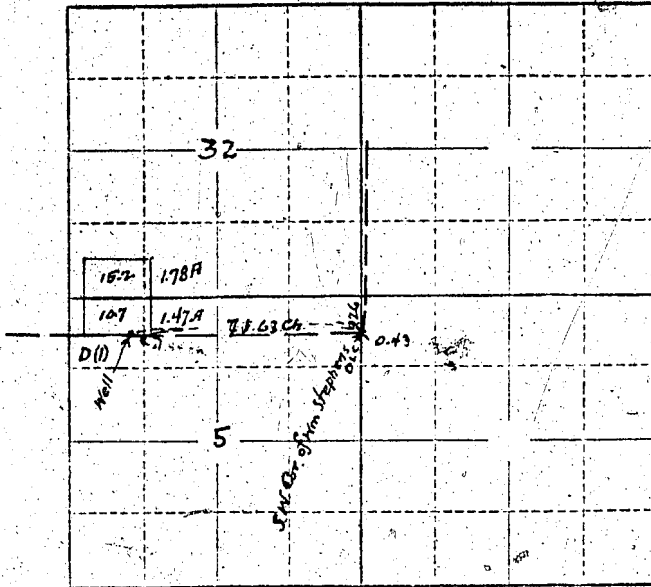

Locate well and acreage of irrigated land on plat.

Scale: 2" = 1 Mile

STATE OF OREGON

County of Marion

ss.

I, \_\_\_\_\_, being first duly sworn, do hereby certify that I have read the foregoing Registration Statement and that all of the items therein contained are true to the best of my knowledge and belief.

Burton L. Christensen  
(Signature of Registrant)

Subscribed and sworn to before me this 3rd day of December, 1957

My commission expires June 12th 1961

Wm. S. Bartholomew  
(Notary Public)

(SEAL)

### CERTIFICATE OF REGISTRATION

STATE OF OREGON

County of Marion

ss.

This is to certify that the foregoing Registration Statement was received in the office of the State Engineer on the 3rd day of December, 1957, at 8:00 o'clock A.M. and has been duly recorded in said office in Book No. 2 of Registration Statements on page GR-780 C.

~~Construction shall be completed by \_\_\_\_\_, 19\_\_\_\_ and the water completely applied to beneficial use by \_\_\_\_\_, 19\_\_\_\_.~~

Witness my hand this 21st day of January, 1958

Lewis A. Steiner  
(State Engineer)

By \_\_\_\_\_

(Deputy)

GR-780 C