

RECEIVED
JUN 12 1957
STATE ENGINEER
SALEM, OREGON

Registration Statement

REGISTERED NO. GR-731
CERTIFICATE NO. GR-731

OF CLAIMANT OF RIGHT TO APPROPRIATE GROUND WATER

(Under Chapter 708, Oregon Laws 1955.)

TO THE STATE ENGINEER OF OREGON:

I, Paul Robert Matheny
of Jacksonville County of Jackson

State of Oregon, do hereby make application for a certificate of registration as evidence of a right to appropriate ground water.

1. Source from which water is withdrawn is Pump well #1
(Flowing well, pump well, infiltration trench, or tunnel)

2. Location is: 1/4 mile SE of Jacksonville
(Approximate distance and direction from nearest city or town)

and is more particularly described as follows:

(a) 1/4 mile SE of Jacksonville
(Give distance and bearing to corner of section or other legal subdivision)

being within 110 1/4 of 204 of Sec. 28, Twp. 37 S, Rge. 2 West
(Smallest legal subdivision) (N. or S.) (E. or W.)

or (b) within limits of recorded platted property, town or city:

in Lot _____, Block _____ of _____
(Name of plat or addition)

County of Jackson
(If within city or town, give name)

3. Construction Work was begun on about 1920; was completed on 1920
(Date) (Date)

and the ground water claimed was first used for the purposes set out below on 1920
(Date)

since which time the water has been used continuously for irrigation
(Continuously or intermittent)

from 1920 to 1957
(Date) (Date)

4. Quantity of water claimed and used is _____ gallons per minute; _____ acre feet per year.

5. Purpose or Purposes for which water is used IRRIGATION

(Domestic, irrigation, municipal, manufacturing, industrial, etc.)

6. Description of Well: Depth 28 feet. Type DUG
(Dug or drilled)

diameter 5 1/2 inches. Elevation of ground at well site 1450 feet, mean sea level.
(As near as known)

Depth to water table 8 feet.

7. Capacity of Well: 70 g.p.m. with 1200 feet drawdown.

_____ g.p.m. with _____ feet drawdown.


Date of test Jan. 6, 1957

If Flowing Well: Measured discharge _____ g.p.m. on _____
(Date)

Shut-in pressure at ground surface _____ lbs. per sq. in. on _____
(Date)

Water is controlled by _____
(Cap, valve, etc.)

Township 37S Range 2W, W.M.
North

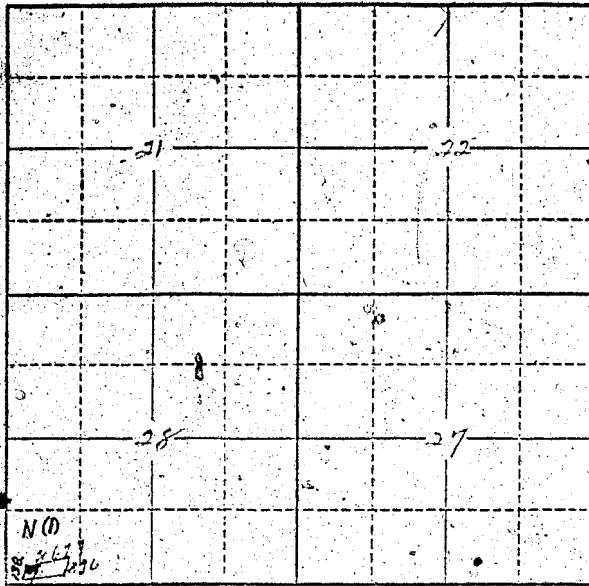

W.C.P. 700 Locate well and acreage of irrigated land on plat.
Scale: 2" = 1 Mile

STATE OF OREGON

County of Jackson } ss.

I, Paul R. Matheny, being first duly sworn, do hereby certify that I have read the foregoing Registration Statement and that all of the items therein contained are true to the best of my knowledge and belief.

Paul R. Matheny
(Signature of Registrant)

Subscribed and sworn to before me this 2nd day of December, 19 57

My commission expires August 25, 1958

W.C.P. 700
(Notary Public)

(SEAL)

CERTIFICATE OF REGISTRATION

STATE OF OREGON

County of Marion } ss.

This is to certify that the foregoing Registration Statement was received in the office of the State Engineer on the 3rd day of December, 19 57, at 1:00 o'clock A. M. and has been duly recorded in said office in Book No. 11 of Registration Statements on page 33-34.

~~Construction shall be completed by 1-1-58 and the water completely applied to beneficial use by 1-1-58.~~

Witness my hand this 24th day of January, 19 58

Laura A. Stanley
(State Engineer)

By _____ (Deputy)

GR-731C