

RECEIVED
STATE ENGINEER
SALES OREGON

Registration Statement

OF CLAIMANT OF RIGHT TO APPROPRIATE GROUND WATER

Well #3

TO THE STATE ENGINEER OF OREGON:

I, Scotty LeFore

of RT. 1 Box 234 Hillsboro County of Washington

(Mailing address)

State of Oregon do hereby make application for a certificate of registration as evidence of a right to appropriate ground water.

1. Source from which water is withdrawn is Drilled Well #3

(Flowing well, pump well, infiltration trench, or tunnel)

2. Location is: 3.9mi. NE. of Hillsboro on Evergreen Rd.

(Approximate distance and direction from nearest city or town)

and is more particularly described as follows:

(a) 3170' East and 550' North of NE. Corner of Lot 40 of James H. Sewall Acreage

(Give distance and bearing to corner of section or other legal subdivision)

being within NW. 1/4 of SE. 1/4 of Sec. 21, Twp. 1N, Rge. 2W

(Smallest legal subdivision)

(N. or S.)

(E. or W.)

or (b) within limits of recorded platted property, town or city:

in Lot 14, Block Five Oaks Subdivision of

(Name of plat or addition)

Hillsboro

County of Washington

(If within city or town, give name)

3. Construction Work was begun on 1946; was completed on 1946

(Date)

(Date)

and the ground water claimed was first used for the purposes set out below on 1946

(Date)

since which time the water has been used Continuously

(Continuously or intermittently)

from 1946 to 1957

(Date)

(Date)

4. Quantity of water claimed and used is 35 gallons per minute; acre feet per year.

5. Purpose or Purposes for which water is used Irrigation

(Domestic, irrigation, municipal, manufacturing, industrial, etc.)

6. Description of Well: Depth 50 feet. Type Drilled

(Dug or drilled)

diameter 12 inches. Elevation of ground at well site 20 feet, mean sea level;

(As near as known)

Depth to water table 35 feet.

7. Capacity of Well: 35 g.p.m. with 35 feet drawdown.

 g.p.m. with feet drawdown.

Date of test 1946

If Flowing Well: Measured discharge g.p.m. on

(Date)

Shut-in pressure at ground surface lbs. per sq. in. on

(Date)

Water is controlled by

(Cap, valve, etc.)

If log of well is not available, give name and address of driller.

11. Infiltration Trench: Covered or open

Dimensions: Length ft. Minimum depth ft. Maximum depth ft.

Bottom width ft. Discharge g.p.m. Date of test

12. Tunnel: Type of lining

Dimensions:
(Length, course, and cross sectional size)

Position of water bearing stratum with reference to portal of tunnel

Log of tunnel: (Preceding table for log of well may be used, if desired. Give footage from portal and character of materials, as pertinent.)

13. Pumping Equipment:

(a) Pump Berkley Jet Pump Capacity 50 g.p.m.
(Make, type and size)

(b) Motor 2 HP. 1phase Electric
(Type and horsepower)


14. Location of area irrigated or to be irrigated, or place of use if for purposes other than irrigation.

Township North or South	Range E. or W. of Willamette Meridian	Section	Forty-acre Tract	Number Acres To Be Irrigated	Date of Reclamation
1N	2W	21	NW 1/4 of Se. 1/4	2 total from 3 wells	1946
"	"	"	NW 1/4 of SE 1/4	0.2	"
"	"	"	SW 1/4 of SE 1/4	0.5	"
"	"	"	NW 1/4 of SW 1/4	1.3	"
"	"	"	NE 1/4 of SW 1/4	1.0	"
"	"	"	SW 1/4 of SW 1/4	8.0	"
"	"	"	SE 1/4 of SW 1/4	13.0	"
				24.0 Total	

15. If the ground water supply is supplemental to an existing water supply, identification of any application for a permit, permit, certificate or adjudicated right to appropriate water made or held by the registrant.

Township 1N Range 2W, W.M.

North

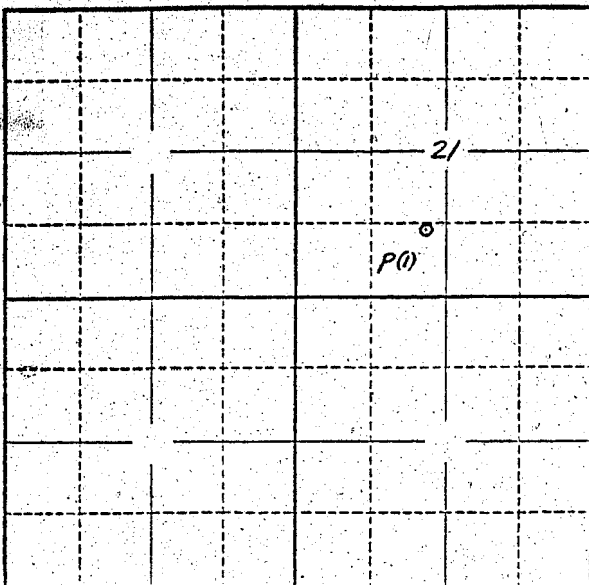

Locate well and acreage of irrigated land on plat.

Scale: 2" = 1 Mile

STATE OF OREGON

County of Washington } ss.

I, Seth Lore, being first duly sworn, do hereby certify that I have read the foregoing Registration Statement and that all of the items therein contained are true to the best of my knowledge and belief.

[Signature]
(Signature of Registrant)

Subscribed and sworn to before me this 29th day of Mar, 1957.

MY COMMISSION EXPIRES MARCH 21, 1959

My commission expires [Signature]
(Notary Public)

(SEAL)

CERTIFICATE OF REGISTRATION

STATE OF OREGON

County of Marion } ss.

This is to certify that the foregoing Registration Statement was received in the office of the State Engineer on the 5th day of December, 1957, at 5:00 o'clock P. M. and has been duly recorded in said office in Book No. 4 of Registration Statements on page GR-738 C.

Witness my hand this 24th day of January, 1958

[Signature]
(State Engineer)

By _____
(Deputy)