

RECEIVED  
JUL 16 1935  
STATE ENGINEER  
SALEM, OREGON

Registration No. GR- 264

Certificate No. GR- 740

### Registration Statement

#### OF CLAIMANT OF RIGHT TO APPROPRIATE GROUND WATER

TO THE STATE ENGINEER OF OREGON:

I, D. E. Nebergall

of Rt. 4, Box 502, Albany County of Senton

State of Oregon, do hereby make application for a certificate of registration as evidence of a right to appropriate ground water.

1. Source from which water is withdrawn is pump well #1  
(Flowing well, pump well, infiltration trench, or tunnel)
2. Location is: 2 miles NE of Albany, Oregon  
(Approximate distance and direction from nearest city or town)

and is more particularly described as follows:

(a) N. 23° 50' E. 1055 feet from the SW corner of NW 1/4 of S. 32 T. 10 S., R. 3 E.  
(Give distance and bearing to corner of section or other legal subdivision)  
being within SW 1/4 of NW 1/4 of Sec. 10, Twp. 10 S., Rge. 3 E.  
(Smallest legal subdivision) (N. or S.) (E. or W.)

or (b) within limits of recorded platted property, town or city: \_\_\_\_\_

in Lot \_\_\_\_\_, Block \_\_\_\_\_ of \_\_\_\_\_  
(Name of plat or addition)

County of Senton

(If within city or town, give name)

3. Construction Work was begun on July 1935; was completed on July 1935  
(Date) (Date)

and the ground water claimed was first used for the purposes set out below on July 1935  
(Date)

since which time the water has been used continuously  
(Continuously or intermittently)

from July 1935 to present time  
(Date) (Date)

4. Quantity of water claimed and used is 100 gallons per minute; 55 acre feet per year.

5. Purpose or Purposes for which water is used Irrigation

(Domestic, irrigation, municipal, manufacturing, industrial, etc.)

6. Description of Well: Depth 90 feet. Type Drilled  
(Dug or drilled)

diameter 12 inches. Elevation of ground at well site 190 feet, mean sea level.  
(As near as known)

Depth to water table 20 feet.

7. Capacity of Well: 100 g.p.m. with 10 feet drawdown.

\_\_\_\_\_ g.p.m. with \_\_\_\_\_ feet drawdown.

Date of test Not tested - estimated

If Flowing Well: Measured discharge \_\_\_\_\_ g.p.m. on \_\_\_\_\_  
(Date)

Shut-in pressure at ground surface \_\_\_\_\_ lbs. per sq. in. on \_\_\_\_\_  
(Date)

Water is controlled by \_\_\_\_\_  
(Cap, valve, etc.)



If log of well is not available, give name and address of driller. W. E. Slopner, Independence, Oregon,  
and Bill Hamilton, 838 E. 3rd Ave., Albany, Oregon

11. Infiltration Trench: Covered or open

Dimensions: Length \_\_\_\_\_ ft. Minimum depth \_\_\_\_\_ ft. Maximum depth \_\_\_\_\_ ft.

Bottom width \_\_\_\_\_ ft. Discharge \_\_\_\_\_ g.p.m. Date of test \_\_\_\_\_

12. Tunnel: Type of lining \_\_\_\_\_

Dimensions: \_\_\_\_\_  
(Length, course, and cross sectional size)

Position of water bearing stratum with reference to portal of tunnel \_\_\_\_\_

Log of tunnel: (Preceding table for log of well may be used, if desired. Give footage from portal and character of materials, as pertinent.)

13. Pumping Equipment:

(a) Pump Pacific Deep well Capacity 150 g.p.m.  
(Make, type and size)

(b) Motor 5 H. P. electric  
(Type and horsepower)


14. Location of area irrigated or to be irrigated, or place of use if for purposes other than irrigation.

Township North or South	Range E. or W. of Willamette Meridian	Section	Forty-acre Tract	Number Acres To Be Irrigated	Date of Reclamation
10 S	3 W	32	SW $\frac{1}{4}$ of NW $\frac{1}{4}$	21.6	July 1935
10 S	3 W	32	SE $\frac{1}{4}$ of NW $\frac{1}{4}$	0.4	" "
				22.0	

15. If the ground water supply is supplemental to an existing water supply, identification of any application for a permit, permit, certificate or adjudicated right to appropriate water made or held by the registrant.

Township 10 S. Range 3 W., W.M.

North

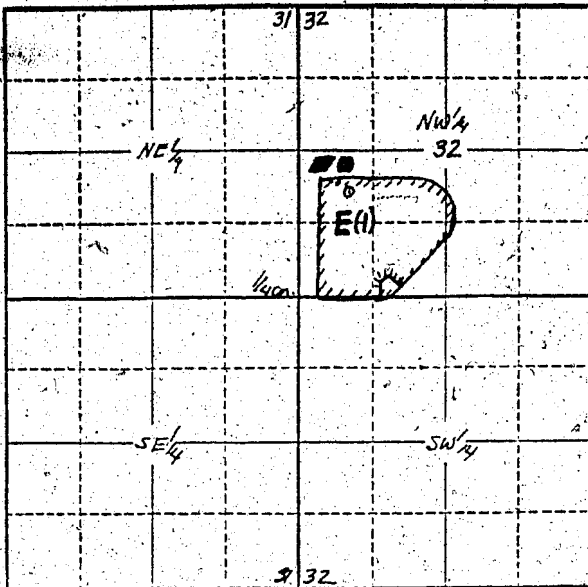

Locate well and acreage of irrigated land on plat.

Scale: 2" = 1 Mile

STATE OF OREGON

County of Linn

ss.

I, D. E. Nebergall, being first duly sworn, do hereby certify that I have read the foregoing Registration Statement and that all of the items therein contained are true to the best of my knowledge and belief.

*D. E. Nebergall*  
(Signature of Registrant)

Subscribed and sworn to before me this 4 day of December, 1957.

My commission expires

*Richard Staff*  
(Notary Public)

(SEAL)

CERTIFICATE OF REGISTRATION

STATE OF OREGON

County of Marion

ss.

This is to certify that the foregoing Registration Statement was received in the office of the State Engineer on the 6th day of December, 1957, at 3:00 o'clock A.M. and has been duly recorded in said office in Book No. 4 of Registration Statements on page 62-710 C.

Witness my hand this 21th day of January, 1958.

*Lewis A. Stanley*  
(State Engineer)

By

(Deputy)

GR - 710 C

# 15.00