

OF CLAIMANT OF RIGHT TO APPROPRIATE GROUND WATER

(Under Chapter 708, Oregon Laws 1955.)

TO THE STATE ENGINEER OF OREGON:

I, We Vernon E. Lyda and Louine B. Lyda
of North Forest Grove County of WASHINGTON

State of OR. yan do hereby make application for a certificate of registration as evidence of a right to appropriate ground water.

- 1. Source from which water is withdrawn is Flowing Well
(Flowing well, pump well, infiltration trench, or tunnel)
- 2. Location is: 6 mi. North Forest Grove on Thatcher Road
(Approximate distance and direction from nearest city or town)

and is more particularly described as follows:

(a) N 80° 43' W 1841.71 To NW corner section 11
(Give distance and bearing to corner of section or other legal subdivision)

being within NE 1/4 NW 1/4 of Sec. 11 Twp. 1 N Rge. 4 W
(Smallest legal subdivision) (N. or S.) (E. or W.)

or (b) within limits of recorded platted property, town or city:

in Lot _____ Block _____ of _____
(Name of plat or addition)

County of WASHINGTON
(If within city or town, give name)

3. Construction Work was begun on 20 Aug 1952 was completed on Oct 16 1952
(Date) (Date)

and the ground water claimed was first used for the purposes set out below on Oct 16 1952
(Date)

since which time the water has been used Continuously
(Continuously or intermittent)

from 1952 to DATE
(Date) (Date)

4. Quantity of water claimed and used is 20 gallons per minute; 1 acre feet per year.

5. Purpose or Purposes for which water is used Domestic and Irrigation of YARD & large Garden
(Domestic, irrigation, municipal, manufacturing, industrial, etc.)

6. Description of Well: Depth 410 feet. Type Drilled
(Dug or drilled)
diameter 6 inches. Elevation of ground at well site 180 feet, mean sea level.
(As near as known)
Depth to water table 100 feet.

7. Capacity of Well: 30 g.p.m. with 55 feet drawdown.
6-8 g.p.m. with 0 feet drawdown.


Date of test Oct 10 1952

If Flowing Well: Measured discharge 6-8 g.p.m. on Oct 10 1952
(Date)

Shut-in pressure at ground surface 3 lbs. per sq. in. on Oct 10 1952
(Date)

Water is controlled by CAP & Valve
(Cap, valve, etc.)

Township 1N Range 4W, W.M.
North

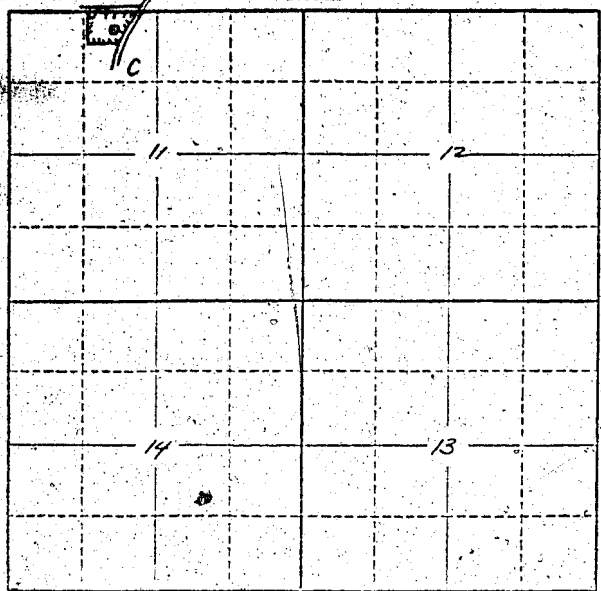

Locate well and acreage of irrigated land on plat.
Scale: 2" = 1 Mile

STATE OF OREGON
County of Washington ss.

We Vernon E. Lyda & Louine B. Lyda, being first duly sworn, do hereby certify that I have read the foregoing Registration Statement and that all of the items therein contained are true to the best of my knowledge and belief.

Vernon E. Lyda
(Signature of Registrant)

Subscribed and sworn to before me this 26th day of November, 19 57

My commission expires Aug 17, 1959

J. H. Guthrie
(Notary Public)

(SEAL)

CERTIFICATE OF REGISTRATION

STATE OF OREGON
County of Marion ss.

This is to certify that the foregoing Registration Statement was received in the office of the State Engineer on the 24th day of December, 19 57, at 8:00 o'clock A. M. and has been duly recorded in said office in Book No. 1 of Registration Statements on page 62-744 C.

~~Construction shall be completed by 10-1-58 and the water completely applied to beneficial use by 10-1-58~~

Witness my hand this 24th day of January, 19 58

Lewis A. Stanley
(State Engineer)

\$150

By _____
(Deputy)

GR-744 C