

Registration Statement

OF CLAIMANT OF RIGHT TO APPROPRIATE GROUND WATER

TO THE STATE ENGINEER OF OREGON:

1. Ed or Zislinski

of 5610 Stapel Green Rd NE County of Marion

State of Oregon do hereby make application for a certificate of registration as evidence of a right to appropriate ground water.

1. Source from which water is withdrawn is pump well #1
(Flowing well, pump well, infiltration trench, or tunnel)

2. Location is: 5 miles from Salem Ore
(Approximate distance and direction from nearest city or town)

and is more particularly described as follows:

(a) 980 feet west and 540 feet north from SE corner of Section 32
(Give distance and bearing to corner of section or other legal subdivision)

being within SE 1/4 of SE 1/4 of Sec. 32, Twp. 6 S, Rge. 2 W
(Smallest legal subdivision) (N. or S.) (E. or W.)

or (b) within limits of recorded platted property, town or city:

in Lot _____, Block _____ of _____
(Name of plat or addition)

County of _____
(If within city or town, give name)

3. Construction Work was begun on aug 1, 1945 was completed on aug 20, 1945
(Date) (Date)

and the ground water claimed was first used for the purposes set out below on spring 1946
(Date)

since which time the water has been used intermittently
(Continuously or intermittently)

from may 1946 to oct 1957
(Date) (Date)

4. Quantity of water claimed and used is 125 gallons per minute; _____ acre feet per year.

5. Purpose or Purposes for which water is used irrigation
(Domestic, irrigation, municipal, manufacturing, industrial, etc.)

6. Description of Well: Depth 99 feet. Type drilled
(Dug or drilled)

diameter 8 inches. Elevation of ground at well site 178 ft feet, mean sea level.
(As near as known)

Depth to water table 33 feet.

7. Capacity of Well: 120 g.p.m. with 42 feet drawdown.

_____ g.p.m. with _____ feet drawdown.


Date of test 1945

If Flowing Well: Measured discharge _____ g.p.m. on _____
(Date)

Shut-in pressure at ground surface _____ lbs. per sq. in. on _____
(Date)

Water is controlled by _____
(Cap, valve, etc.)

Township 6S Range 2W, W.M.
North

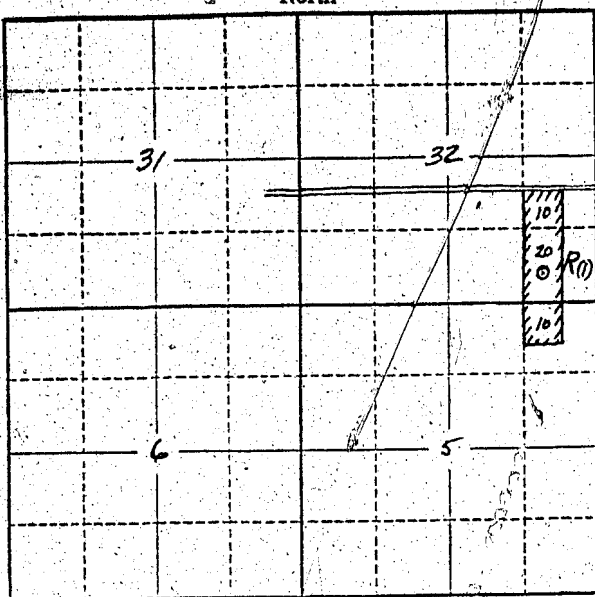

Locate well and acreage of irrigated land on plat:

Scale: 2" = 1 Mile

STATE OF OREGON

County of Marion } ss.

I, _____, being first duly sworn, do hereby certify that I have read the foregoing Registration Statement and that all of the items therein contained are true to the best of my knowledge and belief.

Edw. Ziebinski
(Signature of Registrant)

Subscribed and sworn to before me this 10th day of December, 1957.

My commission expires June 12th, 1961

Wm. S. Bartholomew
(Notary Public)

(SEAL)

CERTIFICATE OF REGISTRATION

STATE OF OREGON

County of Marion } ss.

This is to certify that the foregoing Registration Statement was received in the office of the State Engineer on the 10th day of December, 1957, at 11:00 o'clock A. M. and has been duly recorded in said office in Book No. _____ of Registration Statements on page GR-715 C.

Witness my hand this 21th day of January, 1958

Laura A. Stanley
(State Engineer)

By _____

(Deputy)

GR - 745 C