

Registration No. GR-771

Certificate No. GR-715

Registration Statement

OF CLAIMANT OF RIGHT TO APPROPRIATE GROUND WATER

TO THE STATE ENGINEER OF OREGON:

I, Batech Bros by James Batech
of P.O. Box 91 Mt. Angel, Ore. County of Truitt
(Mailing address)

State of Ore. do hereby make application for a certificate of registration as evidence of a right to appropriate ground water.

1. Source from which water is withdrawn is D.P.M.D. Well
(Flowing well, pump well, infiltration trench, or tunnel)

2. Location is: 3 1/2 mi NE of Hood River
(Approximate distance and direction from nearest city or town)

and is more particularly described as follows:

(a) 2350' W 250' S From NE Corner of Section 15
From the N.W. corner being S.W. 745 FT.
(Give distance and bearing to corner of section or other legal subdivision)

being within North 1/4 of Sec. 15, Twp. 5 S, Rge. 1 W
(Smallest legal subdivision) (N. or S.) (E. or W.)

or (b) within limits of recorded platted property, town or city:

in Lot _____, Block _____ of _____
(Name of plat or addition)

County of _____
(If within city or town, give name)

3. Construction Work was begun on Sept. 1, 1951; was completed on Sept. 17, 1951
(Date) (Date)

and the ground water claimed was first used for the purposes set out below on June, 1952
(Date)

since which time the water has been used Continuously Even during
(Continuously or intermittently)

from June 1952 to Sept. 1, 1957
(Date) (Date)

4. Quantity of water claimed and used is 430 gallons per minute; 190 acre feet per year.

5. Purpose or Purposes for which water is used Irrigation

(Domestic, irrigation, municipal, manufacturing, industrial, etc.)

6. Description of Well: Depth 142.5 feet. Type Drilled
(Dug or drilled)

diameter 10 inches. Elevation of ground at well site 150 feet, mean sea level.
(As near as known)

Depth to water table 24 feet.

7. Capacity of Well: 360 g.p.m. with 7.9 feet drawdown.

430 g.p.m. with 1.9 feet drawdown.

Date of test Sept. 16, 51

If Flowing Well: Measured discharge _____ g.p.m. on _____
(Date)

Shut-in pressure at ground surface _____ lbs. per sq. in. on _____
(Date)

Water is controlled by _____
(Cap. valve, etc.)

8. Casing: (Give diameter, commercial specifications and depth below ground surface of each casing size.)

10 inch diameter from 10 to 145 feet
 inch diameter from to feet
 inch diameter from to feet
 inch diameter from to feet

Describe and show depth of shoe, plug, adapter, liner or other details: *Hardened - Standard*
10" Drive shoe on bottom of 10" pipe

9. Perforated Casings or Screens:

Perforations 8 rows - 3/8" x 1/2" slots from 77 to 90
(Number per foot and size of perforations, or describe screen)
B Per ft from 127 to 145
 from to
 from to

10. Log of Well: (Describe each stratum or formation clearly, indicate if water bearing, and give thickness and depth as indicated.)

MATERIAL	Thickness (Feet)	Depth to Bottom (Feet)
<i>soil & Brown silt</i>	<i>73</i>	<i>73</i>
<i>sand & Gravel</i>	<i>12</i>	<i>73</i>
<i>Blue clay</i>	<i>25</i>	<i>73</i>
<i>sand</i>	<i>8</i>	<i>113</i>
<i>Coarse Gravel</i>	<i>32</i>	<i>145</i>

If log of well is not available, give name and address of driller:

11. Infiltration Trench: Covered or open

Dimensions: Length ft. Minimum depth ft. Maximum depth ft.

Bottom width ft. Discharge g.p.m. Date of test

12. Tunnel: Type of lining

Dimensions:
(Length, course, and cross sectional size)

Position of water bearing stratum with reference to portal of tunnel

Log of tunnel: (Preceding table for log of well may be used, if desired. Give footage from portal and character of materials, as pertinent.)

13. Pumping Equipment:

(a) Pump *COOK Turbine* Capacity *430* g.p.m.
(Make, type and size)


(b) Motor *30 H.P.*
(Type and horsepower)

14. Location of area irrigated or to be irrigated, or place of use if for purposes other than irrigation.

Township North or South	Range E. or W. of Willamette Meridian	Section	Forty-acre Tract	Number Acres To Be Irrigated	Date of Reclamation
<i>T 5 S</i>	<i>R 1 W</i>	<i>15</i>		<i>74.82</i>	<i>June 1952</i>
<i>T 5 S</i>	<i>R 1 W</i>	<i>15</i>		<i>20</i>	<i>June 1952</i>
				<i>total 94.82</i>	
<i>T 5 S</i>	<i>R 1 W</i>	<i>16</i>	<i>NW 1/4 NE 1/2</i>	<i>28 1/2</i>	<i>June 1952</i>
<i>U</i>	<i>"</i>	<i>"</i>	<i>NE 1/4 NW 1/4</i>	<i>18</i>	
<i>"</i>	<i>"</i>	<i>"</i>	<i>SE 1/4 NW 1/4</i>	<i>20</i>	
<i>"</i>	<i>"</i>	<i>"</i>	<i>SW 1/4 NE 1/4</i>	<i>28 1/2</i>	
<i>"</i>	<i>"</i>	<i>"</i>		<i>95.0 Total</i>	

15. If the ground water supply is supplemental to an existing water supply, identification of any application for a permit, permit, certificate or adjudicated right to appropriate water made or held by the registrant.

Township 5S Range 1W, W.M.
North

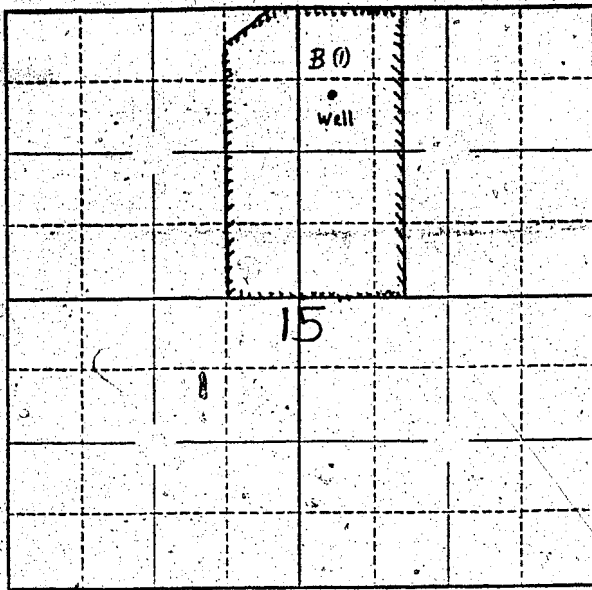

Locate well and acreage of irrigated land on plat.

Scale: $\frac{1}{4}$ - 1 Mile

STATE OF OREGON

County of Marion } ss.

I, _____, being first duly sworn, do hereby certify that I have read the foregoing Registration Statement and that all of the items therein contained are true to the best of my knowledge and belief.

Butel ...
(Signature of Registrant)

Subscribed and sworn to before me this 10th day of December, 1957.

My commission expires June 12th, 1961 Wm. S. Bartholomew
(Notary Public)

(SEAL)

CERTIFICATE OF REGISTRATION

STATE OF OREGON

County of Marion } ss.

This is to certify that the foregoing Registration Statement was received in the office of the State Engineer on the 10th day of December, 1957 at 1:30 o'clock P. M. and has been duly recorded in said office in Book No. 4 of Registration Statements on page GR-746 C.

Witness my hand this 24th day of January, 1958

Laura A. Stanley
(State Engineer)

By _____
(Deputy)

GR - 745 C