

REGISTRATION NO. 67-876  
CERTIFICATE NO. GR-751

# Registration Statement

## OF CLAIMANT OF RIGHT TO APPROPRIATE GROUND WATER

(Under Chapter 708, Oregon Laws 1955.)

TO THE STATE ENGINEER OF OREGON:

I, John Nelson Whitaker

of Coburg County of Lane

State of Oregon, do hereby make application for a certificate of registration as evidence of a right to appropriate ground water.

1. Source from which water is withdrawn is Pump Well  
(Flowing well, pump well, infiltration trench, or tunnel)

2. Location is: 1/4 of a mile west of Coburg  
(Approximate distance and direction from nearest city or town)

and is more particularly described as follows:

(a) So. 59°52' West 556' from the S.W. Corner of the Issac Van Duyne  
(Give distance and bearing to corner of section or other legal subdivision)

being within N.W. 1/4 of N.E. 1/4 of Sec. 32, Twp. 16 S., Rge. 3 W.  
(Smallest legal subdivision) (N. or S.) (E. or W.)

or (b) within limits of recorded platted property, town or city:

in Lot \_\_\_\_\_ Block \_\_\_\_\_ of \_\_\_\_\_  
(Name of plat or addition)

County of \_\_\_\_\_  
(If within city or town, give name)

3. Construction Work was begun on 1929; was completed on 1929  
(Date) (Date)

and the ground water claimed was first used for the purposes set out below on 1929  
(Date)

since which time the water has been used Continuously  
(Continuously or Intermittently)

from 1929 to 1957  
(Date) (Date)

4. Quantity of water claimed and used is 250 gallons per minute; 3 acre feet per year.

5. Purpose or Purposes for which water is used Irrigation

(Domestic, Irrigation, municipal, manufacturing, industrial, etc.)

6. Description of Well: Depth 10 1/2 feet. Type Dug  
(Dug or drilled)

diameter 12 inches. Elevation of ground at well site 320 feet, mean sea level.  
(As near as known)

Depth to water table 1 1/2 feet.

7. Capacity of Well: 500 g.p.m. with 4 feet drawdown.

\_\_\_\_\_ g.p.m. with \_\_\_\_\_ feet drawdown.

Date of test July 1952

If Flowing Well: Measured discharge \_\_\_\_\_ g.p.m. on \_\_\_\_\_  
(Date)

Shut-in pressure at ground surface \_\_\_\_\_ lbs. per sq. in. on \_\_\_\_\_  
(Date)


Water is controlled by \_\_\_\_\_  
(Cap, valve, etc.)

Pa. 0219





Township 16.5 Range 3W W.M.  
North

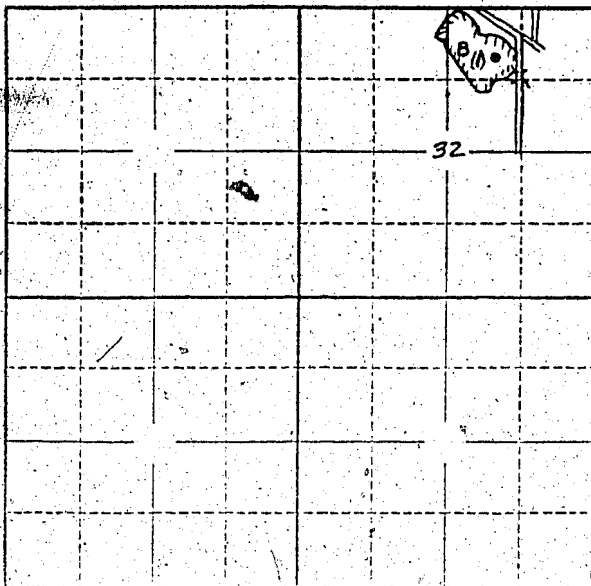

Locate well and acreage of irrigated land on plat.  
Scale: 2" = 1 Mile

STATE OF OREGON

County of Lane

ss.

I, John Nelson Whitaker, being first duly sworn, do hereby certify that I have read the foregoing Registration Statement and that all of the items therein contained are true to the best of my knowledge and belief.

*John Nelson Whitaker*  
(Signature of Registrant)

Subscribed and sworn to before me this 11<sup>th</sup> day of December, 1957

My commission expires Sept. 8, 1960

*[Signature]*  
(Notary Public)

(SEAL)

**CERTIFICATE OF REGISTRATION**

STATE OF OREGON

County of Marion

ss.

This is to certify that the foregoing Registration Statement was received in the office of the State Engineer on the 10th day of December, 1957, at 2:00 o'clock P.M. and has been duly recorded in said office in Book No.                      of Registration Statements on page 12-122

Construction shall be completed by                      1957 and the water completely applied to beneficial use by                      1957

Witness my hand this 21<sup>st</sup> day of January, 1958

*Laura A. Stanley*  
(State Engineer)

By                       
(Deputy)

GR-751 C