

RECEIVED
JAN 13 1955
STATE ENGINEER
SALEM, OREGON

Registration Statement

OF CLAIMANT OF RIGHT TO APPROPRIATE GROUND WATER

(Under Chapter 703, Oregon Laws 1955.)

TO THE STATE ENGINEER OF OREGON:

I, Mark E. and Laura A. Smith

of Harrisburg County of Linn

State of Oregon, do hereby make application for a certificate of registration as evidence of a right to appropriate ground water.

1. Source from which water is withdrawn is Rump well
(Flowing well, pump well, infiltration trench, or tunnel)

2. Location is: 5.3 miles south of Harrisburg, Oregon
(Approximate distance and direction from nearest city or town)

and is more particularly described as follows:

(a) N. 5° 10' E. 21.5 chains from the SW corner of S. 1 T. 16 S. R. 4 W.
(Give distance and bearing to corner of section or other legal subdivision)

being within NW 1/4 of SW 1/4 of Sec. 1, Twp. 16 S., Rge. 4 W.
(Smallest legal subdivision) (N. or S.) (E. or W.)

or (b) within limits of recorded platted property, town or city:

in Lot _____, Block _____ of _____
(Name of plat or addition)

County of Linn
(If within city or town, give name)

3. Construction Work was begun on Dec. 3, 1949; was completed on Dec. 5, 1949
(Date) (Date)

and the ground water claimed was first used for the purposes set out below on May 10, 1950
(Date)

since which time the water has been used continuously
(Continuously or intermittently)

from May 10, 1950 to Sept. 3, 1955
(Date) (Date)

4. Quantity of water claimed and used is 300 gallons per minute; 50 acre feet per year.

5. Purpose or Purposes for which water is used Irrigation

(Domestic, irrigation, municipal, manufacturing, industrial, etc.)

6. Description of Well: Depth 25 feet. Type driven
(Dug or drilled)

diameter 4 inches. Elevation of ground at well site 335 feet, mean sea level.
(As near as known)

Depth to water table 10 feet.

7. Capacity of Well: 400 g.p.m. with 14 feet drawdown.

_____ g.p.m. with _____ feet drawdown.

Date of test May 10, 1950

If Flowing Well: Measured discharge _____ g.p.m. on _____
(Date)

Shut-in pressure at ground surface _____ lbs. per sq. in. on _____
(Date)

Water is controlled by _____
(Chp. valve, etc.)

If log of well is not available, give name and address of driller.....

11. Infiltration Trench: Covered or open.....

Dimensions: Length ft. Minimum depth ft. Maximum depth ft.

Bottom width ft. Discharge g.p.m. Date of test

12. Tunnel: Type of lining

Dimensions:
(Length, course, and cross sectional size)

Position of water bearing stratum with reference to portal of tunnel

Log of tunnel: (Preceding table for log of well may be used, if desired. Give footage from portal and character of materials, as pertinent.)

13. Pumping Equipment:

(a) Pump 3" Pacific centrifugal pump Capacity 320 g.p.m.
(Make, type and size)

(b) Motor 10 H. P. electric motor
(Type and horsepower)


14. Location of area irrigated or to be irrigated, or place of use if for purposes other than irrigation.

Township North or South	Range E. or W. of Willamette Meridian	Section	Forty-acre Tract	Number Acres To Be Irrigated	Date of Reclamation
16 S	4 W	2	NE $\frac{1}{4}$ of SE $\frac{1}{4}$	6.1	May 10, 1950 Prior to 1900
16 S	4 W	2	SE $\frac{1}{4}$ of SE $\frac{1}{4}$	8.4	1944
16 S	4 W	1	NW $\frac{1}{4}$ of SW $\frac{1}{4}$	4.7	1944
16 S	4 W	1	SW $\frac{1}{4}$ of SW $\frac{1}{4}$	5.8	1944
				25.0	

Beginning at a point which is North 0°31' E. 16.35 chains and S. 89°45' E. 47.36 chains from the Southwest corner of the John Ingram and wife Cl. #56 in T. 16 S., R. 4 W. of the Will. Mer. in Linn County, Oregon; thence North 16.68 chains to the North line of said Claim; thence along said line S. 89°45' E. 17.70 chains to the center of the County Road; thence Southwesterly along the center of said road to a point due East of the place of beginning; thence West to said place of beginning and containing 29 acres, more or less.

15. If the ground water supply is supplemental to an existing water supply, identification of any application for a permit, permit, certificate or adjudicated right to appropriate water made or held by the registrant.

Township 16 S Range 4 W W.M.
North

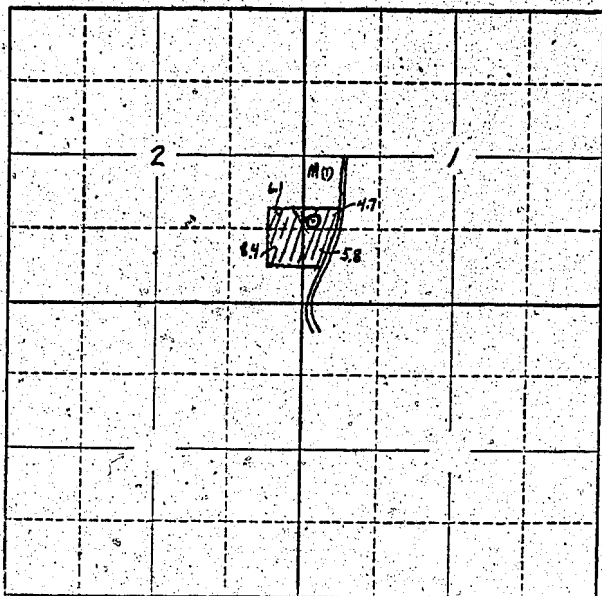

Locate well and acreage of irrigated land on plat.
Scale: 2" = 1 Mile

STATE OF OREGON

County of Linn

ss.

I, Mark B. and Laura A. Smith being first duly sworn, do hereby certify that I have read the foregoing Registration Statement and that all of the items therein contained are true to the best of my knowledge and belief.

Laura A. Smith
Mark B. Smith
(Signature of Registrant)

Subscribed and sworn to before me this 6th day of January, 1956

My commission expires Aug. 10, 1959

Ray Jehu
(Notary Public)

(SEAL)

CERTIFICATE OF REGISTRATION

STATE OF OREGON

County of Marion

ss.

This is to certify that the foregoing Registration Statement was received in the office of the State Engineer on the 13th day of January, 1956; at 8:00 o'clock A. M. and has been duly recorded in said office in Book No. 1 of Registration Statements on page 67

Construction shall be completed by _____, 19____, and the water completely applied to beneficial use by _____, 19____.

Witness my hand this 24th day of February, 1956

Lewis A. Stanley
(State Engineer)

By _____
(Deputy)