

Registration Statement

OF CLAIMANT OF RIGHT TO APPROPRIATE GROUND WATER

TO THE STATE ENGINEER OF OREGON:

I, Ernest L. Zielinski

of 5570 Hazel Green Salem County of MARION

State of Oregon do hereby make application for a certificate of registration as evidence of a right to appropriate ground water.

1. Source from which water is withdrawn is Pump well #1
(Flowing well, pump well, infiltration trench, or tunnel)

2. Location is: 1332 W
(Approximate distance and direction from nearest city or town)

and is more particularly described as follows:

(a) 1332' W & 705' N from SE corner section 32
(Give distance and bearing to corner of section or other legal subdivision)

being within SW 1/4 SE 1/4 of Sec. 32, Twp. 6S, Rge. 2W
(Smallest legal subdivision) (N. or S.) (E. or W.)

or within limits of recorded platted property, town or city:

in Lot _____, Block _____ of _____
(Name of plat or addition)

County of _____
(If within city or town, give name)

3. Construction Work was begun on March 1952; was completed on April 3 1952
(Date) (Date)

and the ground water claimed was first used for the purposes set out below on April
(Date)

since which time the water has been used intermittently
(Continuously or intermittently)

from March to Oct
(Date) (Date)

4. Quantity of water claimed and used is 200 gallons per minute; 120 acre feet per year.

5. Purpose or Purposes for which water is used IRRIGATION

(Domestic, irrigation, municipal, manufacturing, industrial, etc.)

6. Description of Well: Depth 117.5 feet. Type Drilled
(Dug or drilled)

diameter 8 inches. Elevation of ground at well site 160 feet, mean sea level.
(As near as known)

Depth to water table 30 feet.

7. Capacity of Well: 350 g.p.m. with 12 feet drawdown.

_____ g.p.m. with _____ feet drawdown.

Date of test MARCH 1952

If Flowing Well: Measured discharge _____ g.p.m. on _____
(Date)

Shut-in pressure at ground surface _____ lbs. per sq. in. on _____
(Date)

Water is controlled by _____
(Cap, valve, etc.)

8. Casing: (Give diameter, commercial specifications and depth below ground surface of each casing size.)

8 inch diameter from 0 to 112.5 feet
 inch diameter from to feet
 inch diameter from to feet
 inch diameter from to feet

Describe and show depth of shoe, plug, adapter, liner or other details:

Davis shoe

9. Perforated Casings or Screens:

perforated from 80 to 85
(Number per foot and size of perforations, or describe screen)
 perforated from 100 to 103
 4 or 5 perforations from 115 to 117
 from to

10. Log of Well: (Describe each stratum or formation clearly, indicate if water bearing, and give thickness and depth as indicated.)

MATERIAL	Thickness (Feet)	Depth to Bottom (Feet)
Not Available		

If log of well is not available, give name and address of driller. R. Stadel & Sons

1. Infiltration Trench: Covered or open

Dimensions: Length ft. Minimum depth ft. Maximum depth ft.

Bottom width ft. Discharge g.p.m. Date of test

2. Tunnel: Type of lining

Dimensions:
(Length, course, and cross sectional size)

Position of water bearing stratum with reference to portal of tunnel

Log of tunnel: (Preceding table for log of well may be used, if desired. Give footage from portal and character of materials, as pertinent.)

13. Pumping Equipment:

(a) Pump PANAMA TURBINE Capacity 240 g.p.m.
(Make, type and size)


(b) Motor 10 H.P.
(Type and horsepower)

14. Location of area irrigated or to be irrigated, or place of use if for purposes other than irrigation.

Township North or South	Range E. or W. of Williamsite Meridian	Section	Forty-acre Tract	Number Acres To Be Irrigated	Date of Reclamation
T6S	R2W	32	NW ¹ / ₄ SE ¹ / ₄	10	1952
6S	2W	32	SW ¹ / ₄ SE ¹ / ₄	20	
7S	2W	5	NW ¹ / ₄ NE ¹ / ₄	10	
				<u>40</u>	

15. If the ground water supply is supplemental to an existing water supply, identification of any application for a permit, permit, certificate or adjudicated right to appropriate water made or held by the registrant.

Township 6S Range 2W, W.M.
North

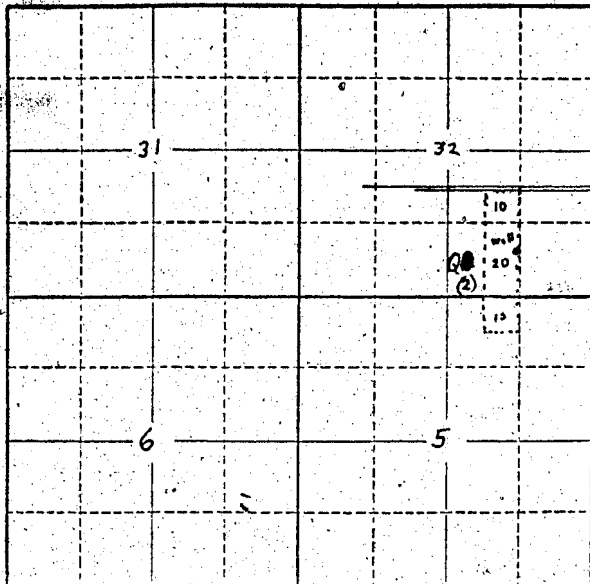

Locate well and acreage of irrigated land on plat.
Scale: 2" = 1 Mile

STATE OF OREGON

County of Marion

} ss.

I, Ernest S. Zolinski, being first duly sworn, do hereby certify that I have read the foregoing Registration Statement and that all of the items therein contained are true to the best of my knowledge and belief.

Ernest S. Zolinski
(Signature of Registrant)

Subscribed and sworn to before me this 13th day of December, 1957.

My commission expires Sept. 8, 1960

Robert H. Shale
(Notary Public)

(SEAL)

CERTIFICATE OF REGISTRATION

STATE OF OREGON

County of Marion

} ss.

This is to certify that the foregoing Registration Statement was received in the office of the State Engineer on the 13 day of December, 1957, at 8:00 o'clock A. M. and has been duly recorded in said office in Book No. 4 of Registration Statements on page GR - 760 C

Witness my hand this 4th day of February, 1958

Lewis A. Stanley
(State Engineer)

By _____
(Deputy)