

RECEIVED

DEC 10 1957

STATE ENGINEER
SALEM, OREGON

Registration Statement

REGISTRATION NO. GR 787

CERTIFICATE NO. GR-761

OF CLAIMANT OF RIGHT TO APPROPRIATE GROUND WATER

(Under Chapter 708, Oregon Laws 1955.)

TO THE STATE ENGINEER OF OREGON:

I, Frank J. Gratsinger

of Gervais County of Marion

State of Oregon, do hereby make application for a certificate of registration as evidence of a right to appropriate ground water.

1. Source from which water is withdrawn is Well No. 1
(Flowing well, pump well, infiltration trench, or tunnel)

2. Location is: 1 1/2 miles S.W. of Gervais
(Approximate distance and direction from nearest city or town)

and is more particularly described as follows:

(a) 2850' west and 750' south of N.E. cor. of Section 34
(Give distance and bearing to corner of section or other legal subdivision)

being within N.E. 1/4 of N.W. 1/4 of Sec. 34 Twp. 5 S. Rge. 2 W.
(Smallest legal subdivision) (N. or S.) (E. or W.)

or (b) within limits of recorded platted property, town or city:

in Lot _____ Block _____ of _____
(Name of plat or addition)

County of _____
(If within city or town, give name)

3. Construction Work was begun on October, 1949; was completed on October, 1949
(Date) (Date)

and the ground water claimed was first used for the purposes set out below on April, 1950
(Date)

since which time the water has been used continuously for domestic
(Continuously or intermittently)

from April 1 to Oct. 31 for irrigation.
(Date) (Date)

4. Quantity of water claimed and used is 540 gallons per minute; 250 acre feet per year.

5. Purpose or Purposes for which water is used Irrigation

(Domestic, irrigation, municipal, manufacturing, industrial, etc.)

6. Description of Well: Depth 137 feet. Type drilled
(Dug or drilled)

diameter 8 inches. Elevation of ground at well site 182 feet, mean sea level.
(As near as known)

Depth to water table 18 feet.

7. Capacity of Well: 200 g.p.m. with 12 feet drawdown.

350 g.p.m. with 24 feet drawdown.

Date of test: October, 1950

If Flowing Well: Measured discharge _____ g.p.m. on _____
(Date)

Shut-in pressure at ground surface _____ lbs. per sq. in. on _____
(Date)

Water is controlled by _____
(Cap, valve, etc.)

8 inch diameter from 0 to 137 feet

inch diameter from to feet

inch diameter from to feet

inch diameter from to feet

Describe and show depth of shoe, plug, adapter, liner or other details:

Not known

(Number per foot and size of perforations, or describe screen)

from to

from to

from to

from to

[illegible]

If log of well is not available, give name and address of driller. _____

11. Infiltration Trench: Covered or open

Dimensions: Length ft. Minimum depth ft. Maximum depth ft.

Bottom width ft. Discharge g.p.m. Date of test

12. Tunnel: Type of lining

Dimensions: _____
(Length, course, and cross sectional size)

Position of water bearing stratum with reference to portal of tunnel

Log of tunnel: (Preceding table for log of well may be used, if desired. Give footage from portal and character of materials, as pertinent.)

- 13. Pumping Equipment:**

(a) Pump Peerless - turbine - 4" col. Capacity 200 g.p.m.
(Make, type and size)


(b) Motor Single Phase 7 1/2 H.P.
(Type and horsepower)

14. Location of area irrigated or to be irrigated, or place of use if for purposes other than irrigation.

[illegible]

15. If the ground water supply is supplemental to an existing water supply, identification of any application for a permit, permit, certificate or adjudicated right to appropriate water made or held by the registrant.

Township 5S Range 2W W.M.
North

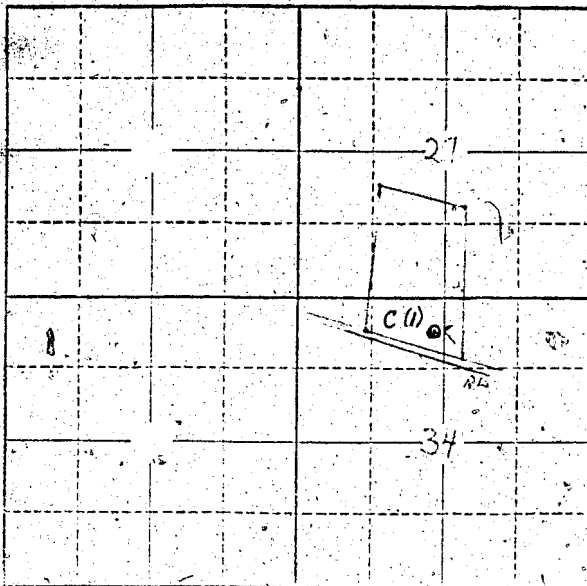

Locate well and acreage of irrigated land on plat.

Scale: 2" = 1 Mile

STATE OF OREGON

County of Marion

I, Frank J. Gratsinger, being first duly sworn, do hereby certify that I have read the foregoing Registration Statement and that all of the items therein contained are true to the best of my knowledge and belief.

Frank J. Gratsinger
(Signature of Registrant)

Subscribed and sworn to before me this 13th day of December, 1957.

My commission expires Feb. 13, 1959

R. F. Garinger
(Notary Public)

(SEAL)

CERTIFICATE OF REGISTRATION

STATE OF OREGON

County of Marion

ss.

This is to certify that the foregoing Registration Statement was received in the office of the State Engineer on the 16 day of December, 1957, at 8:00 o'clock A. M. and has been duly recorded in said office in Book No. 4 of Registration Statements on page GR-761 C.

~~Construction shall be completed by 1958 and the water right shall be completed~~

~~beneficial use by 1958~~

Witness my hand this 4th day of February, 1958.

Laura A. Stanley
(State Engineer)

By _____
(Deputy)

GR-761 C