

RECEIVED

DEC 1 1957
STATE ENGINEER
SALEM, OREGON

Registration Statement

REGISTRATION NO. GR-788

CERTIFICATE NO. GR-762

OF CLAIMANT OF RIGHT TO APPROPRIATE GROUND WATER

(Under Chapter 708, Oregon Laws 1955.)

TO THE STATE ENGINEER OF OREGON:

I, Frank J. Gratsinger

of Gervais County of Marion

State of Oregon; do hereby make application for a certificate of registration as evidence of a right to appropriate ground water.

1. Source from which water is withdrawn is Well No. 2

(Flowing well, pump well, infiltration trench, or tunnel)

2. Location is: 1 1/2 miles S.W. of Gervais, Oregon

(Approximate distance and direction from nearest city or town)

and is more particularly described as follows:

(a) 3150' west and 450' north from N.E. Corner of Section 34

(Give distance and bearing to corner of section or other legal subdivision)

being within S.E. 1/4 of S.W. 1/4 of Sec. 27 Twp. 5 S. Rge. 2 W.

(Smallest legal subdivision)

(N. or S.)

(E. or W.)

or (b) within limits of recorded platted property, town or city:

in Lot Block County of

(Name of plat or addition)

(If within city or town, give name)

3. Construction Work was begun on May 1, 1954

(Date)

was completed on May 14, 1954

(Date)

and the ground water claimed was first used for the purposes set out below on June, 1954

(Date)

since which time the water has been used Intermittently

(Continuously or Intermittently)

from April 1 to October 31

(Date)

(Date)

4. Quantity of water claimed and used is 540 0/100 gallons per minute: 250 acre feet per year.

5. Purpose or Purposes for which water is used

Irrigation

(Domestic, irrigation, municipal, manufacturing, industrial, etc.)

6. Description of Well: Depth 140 feet. Type drilled

(Dug or drilled)

diameter 10 inches. Elevation of ground at well site 182 feet, mean sea level

(As near as known)

Depth to water table 18 feet.

7. Capacity of Well: 225 g.p.m. with 5 feet drawdown.

340 g.p.m. with 15 feet drawdown.

Date of test May 14, 1954

If Flowing Well: Measured discharge g.p.m. on

(Date)

Shut-in pressure at ground surface lbs. per sq. in. on

(Date)

Water is controlled by

(Cap. valve, etc.)

8. Casing: (Give diameter, commercial specifications and depth below ground surface of each casing size.)

10 inch diameter from 0 to 140 feet
inch diameter from to feet
inch diameter from to feet
inch diameter from to feet

Describe and show depth of shoe, plug, adapter, liner or other details:

9. Perforated Casings or Screens:

13 perf. per ft. size $\frac{1}{2}'' \times \frac{1}{4}''$ from 127 to 137
(Number per foot and size of perforations, or describe screen)
from to
from to
from to

10. Log of Well: (Describe each stratum or formation clearly, indicate if water bearing, and give thickness and depth as indicated.)

MATERIAL	Thickness (Feet)	Depth to Bottom (Feet)
Soil	22	22
Sand	95	117
Gravel	23	140

GR-762A

If log of well is not available, give name and address of driller.....

11. Infiltration Trench: Covered or open

Dimensions: Length ft. Minimum depth ft. Maximum depth ft.

Bottom width ft. Discharge g.p.m. Date of test

12. Tunnel: Type of lining

Dimensions:
(Length, course, and cross sectional size)

Position of water bearing stratum with reference to portal of tunnel

Log of tunnel: (Preceding table for log of well may be used, if desired. Give footage from portal and character of materials, as pertinent.)

13. Pumping Equipment:

(a) Pump Peerless - Turbine - 5" column Capacity 340 g.p.m.
(Make, type and size)


(b) Motor Three phase 15 H.P.
(Type and horsepower)

14. Location of area irrigated or to be irrigated, or place of use if for purposes other than irrigation.

Township North or South	Range E. or W. of Williamsite Meridian	Section	Forty-acre Tract	Number Acres To Be Irrigated	Date of Reclamation
5 S	2 W	27	S.W. 1/4 of S.W. 1/4	1	1950
"	"	"	S.E. 1/4 of S.W. 1/4	39	1950 & 54
"	"	"	N.E. 1/4 of S.W. 1/4	16	1954
"	"	"	N.W. 1/4 of S.E. 1/4	3	1954
"	"	"	S.W. 1/4 of S.E. 1/4	10	1954
5 S	2 W	34	N.W. 1/4 of N.E. 1/4	8	1950
"	"	34	N.E. 1/4 of N.W. 1/4	20	1950
"	"	"	N.W. 1/4 of N.W. 1/4	2	1950
				99 Ac.	

15. If the ground water supply is supplemental to an existing water supply, identification of any application for a permit, permit, certificate or adjudicated right to appropriate water made or held by the registrant.

Township 5S Range 2W, W.M.
North

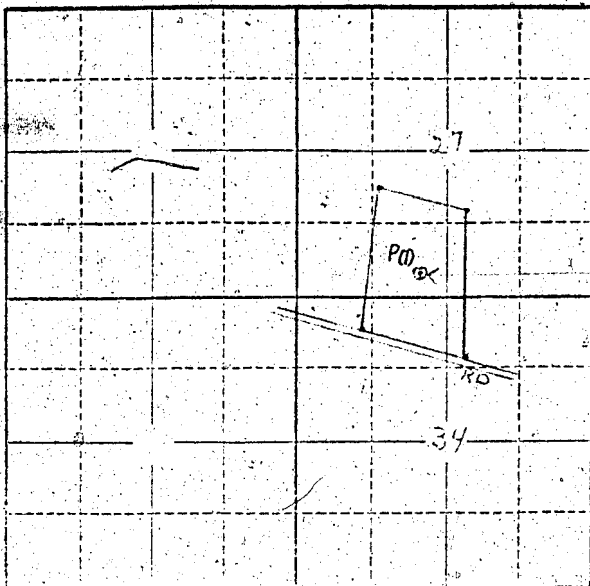

Locate well and acreage of irrigated land on plat.
Scale: 2" = 1 Mile

STATE OF OREGON

County of Marion } ss.

I, Frank J. Gratsinger, being first duly sworn, do hereby certify that I have read the foregoing Registration Statement and that all of the items therein contained are true to the best of my knowledge and belief.

Frank J. Gratsinger
(Signature of Registrant)

Subscribed and sworn to before me this 13th day of December, 19 57.

My commission expires Feb. 13, 1959

H. F. Granger
(Notary Public)

(SEAL)

CERTIFICATE OF REGISTRATION

STATE OF OREGON

County of Marion } ss.

This is to certify that the foregoing Registration Statement was received in the office of the State Engineer on the 16 day of December, 19 57, at 8:00 o'clock A. M. and has been duly recorded in said office in Book No. 4 of Registration Statements on page GR 762-C

Witness my hand this 4th day of February, 19 58

Lewis A. Stanley
(State Engineer)

By _____ (Deputy)

GR-762C