

RECEIVED
DEC 12 1957
STATE ENGINEER
S. E. McCOMBSON

Registration No. GR-282

Certificate No. GR-763

Registration Statement

OF CLAIMANT OF RIGHT TO APPROPRIATE GROUND WATER

Well no 2

TO THE STATE ENGINEER OF OREGON:

I, Cyril Scholten
of 8545 Ingomar Junction Hwy County of Jackson
State of Oregon, do hereby make application for a certificate of registration as evidence
of a right to appropriate ground water.

1. Source from which water is withdrawn is Pumphouse Well
(Flowing well, pump well, infiltration trench, or tunnel)

2. Location is: 3 miles N. of Junction Hwy
(Approximate distance and direction from nearest city or town)

and is more particularly described as follows: 1633 ft. E to a point 642.67 N. S. 111.60 W. Sec. 17

(a) S. 1/2 of S. 17
(Give distance and bearing to corner of section or other legal subdivision)

being within S. 1/2 of S. 17 of Sec. 17, Twp. 15 S, Rge. 4 W
(Smallest legal subdivision) (N. or S.) (E. or W.)

or (b) within limits of recorded platted property, town or city:

in Lot _____ Block _____ of _____
(Name of plat or addition)

County of _____
(If within city or town, give name)

3. Construction Work was begun on _____; was completed on _____
(Date) (Date)

and the ground water claimed was first used for the purposes set out below on July 1, 1942
(Date)

since which time the water has been used Continuously
(Continuously or intermittently)

from July 1 to Sept. 10
(Date) (Date)

4. Quantity of water claimed and used is 250 gallons per minute; 2 1/2 acre
feet per year.

5. Purpose or Purposes for which water is used domestic, irrigation, municipal, manufacturing, industrial, etc.
crop and pasture
(Domestic, irrigation, municipal, manufacturing, industrial, etc.)

6. Description of Well: Depth 30 feet. Type auger
(Dug or drilled)

diameter 4 inches. Elevation of ground at well site 5 feet, mean sea level.
(As near as known)

Depth to water table 15 feet.

7. Capacity of Well: 250 g.p.m. with 4 feet drawdown.

_____ g.p.m. with _____ feet drawdown.

Date of test July 1, 1950

If Flowing Well: Measured discharge _____ g.p.m. on _____
(Date)

Shut-in pressure at ground surface _____ lbs. per sq. in. on _____
(Date)

Water is controlled by _____
(Cap, valve, etc.)

8. Casing: (Give diameter, commercial specifications and depth below ground surface of each casing size.)

..... inch diameter from to feet
..... inch diameter from to feet
..... inch diameter from to feet
..... inch diameter from to feet

Describe and show depth of shoe, plug, adapter, liner or other details:

9. Perforated Casings or Screens:

..... from to
(Number per foot and size of perforations, or describe screen)
..... from to
..... from to
..... from to

10. Log of Well: (Describe each stratum or formation clearly, indicate if water bearing, and give thickness and depth as indicated.)

MATERIAL	Thickness (Feet)	Depth to Bottom (Feet)
In my territory there is an average of six feet well cemented soil and below it is sand and gravel depth unknown		

If log of well is not available, give name and address of driller.

11. Infiltration Trench: Covered or open

Dimensions: Length _____ ft. Minimum _____ ft. Maximum depth _____ ft.

Bottom width _____ ft. Discharge _____ g.p.m. Date of test _____

12. Tunnel: Type of lining

Dimensions: _____
(Length, course, and cross sectional size)

Position of water bearing stratum with reference to portal of tunnel

Log of tunnel: (Preceding table for log of well may be used, if desired. Give footage from portal and character of materials, as pertinent.)

13. Pumping Equipment:

(a) Pump *Leaming 2 1/2* Capacity *250* g.p.m.
(Make, type and size)


(b) Motor *Fairbanks Morse 10 H.P. Electric Motor*
(Type and horsepower)

14. Location of area irrigated or to be irrigated, or place of use if for purposes other than irrigation.

Township North or South	Range E. or W. of Willamette Meridian	Section	Forty-acre Tract	Number Acres To Be Irrigated	Date of Reclamation
<i>15 S</i>	<i>4 N 1/2 W 2</i>	<i>17</i>	<i>S. 1/4, 1/4</i>	<i>6 1/2</i>	<i>1942</i>

15. If the ground water supply is supplemental to an existing water supply, identification of any application for a permit, permit, certificate or adjudicated right to appropriate water made or held by the registrant.

Township 15 S Range 4 W, W.M.
North

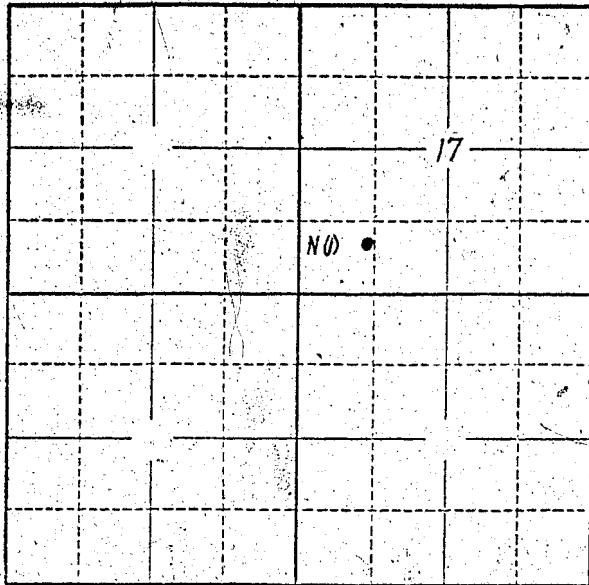

See Map
in GR-608

Locate well and acreage of irrigated land on plat.

Scale: 2" = 1 Mile

STATE OF OREGON

County of Lane } ss.

I, Byrd Scholesing, being first duly sworn, do hereby certify that I have read the foregoing Registration Statement and that all of the items therein contained are true to the best of my knowledge and belief.

Byrd Scholesing
(Signature of Registrant)

Subscribed and sworn to before me this 11th day of December, 1957

My commission expires April 11, 1960

Alvin Stubbeth
(Notary Public)

(SEAL)

My Commission expires April 11, 1960

CERTIFICATE OF REGISTRATION

STATE OF OREGON

County of Marion } ss.

This is to certify that the foregoing Registration Statement was received in the office of the State Engineer on the 12th day of December, 1957, at 2:00 o'clock A. M. and has been duly recorded in said office in Book No. 4 of Registration Statements on page GR-763 C

Witness my hand this 4th day of February, 1958

Lewis A. Stanley
(State Engineer)

By _____ (Deputy)