

REGISTRATION NO. GR-79

CERTIFICATE NO. GR-82

RECEIVED
JAN 13 1956

STATE ENGINEER
SALEM, OREGON

Registration Statement

RECEIVED
JAN 13 1956

STATE ENGINEER
SALEM, OREGON

OF CLAIMANT OF RIGHT TO APPROPRIATE GROUND WATER

(Under Chapter 708, Oregon Laws 1955.)

TO THE STATE ENGINEER OF OREGON:

I, Glen L. and Gloria G. Thurston

of Rt. 2, Box 111, Scio County of Linn

State of Oregon, do hereby make application for a certificate of registration as evidence of a right to appropriate ground water.

1. Source from which water is withdrawn is pump well
(Flowing well, pump well, infiltration trench, or tunnel)

2. Location is: 3.5 miles west of Scio, Oregon
(Approximate distance and direction from nearest city or town)

and is more particularly described as follows:

(a) N. 24° 45' W. 18 from the SE corner of S. 10, T. 11 S., R. 2, W.

(Give distance and bearing to corner of section or other legal subdivision)

being within SE 1/4 of SE 1/4 of Sec. 10, Twp. 10 S., Rge. 2 W.
(Smallest legal subdivision) (N. or S.) (E. or W.)

or (b) within limits of recorded platted property, town or city:

in Lot _____, Block _____ of _____
(Name of plat or addition)

County of Linn
(If within city or town, give name)

3. Construction Work was begun on Sept. 1, 1949; was completed on Oct. 1, 1949
(Date) (Date)

and the ground water claimed was first used for the purposes set out below on June 17, 1950
(Date)

since which time the water has been used continuously
(Continuously or Intermittently)

from June 17, 1950 to Oct. 1, 1955
(Date) (Date)

4. Quantity of water claimed and used is 192 gallons per-minute; 127 acre feet per year.

5. Purpose or Purposes for which water is used Irrigation

(Domestic, irrigation, municipal, manufacturing, industrial, etc.)

6. Description of Well: Depth 64 feet. Type drilled
(Dug or drilled)

diameter 10 inches. Elevation of ground at well site 300 feet, mean sea level.
(As near as known)

Depth to water table 17 feet.

7. Capacity of Well: 220 g.p.m. with 60 feet drawdown.

_____ g.p.m. with _____ feet drawdown.


Date of test June 17, 1950

If Flowing Well: Measured discharge _____ g.p.m. on _____
(Date)

Shut-in pressure at ground surface _____ lbs. per sq. in. on _____
(Date)

Water is controlled by _____
(Cap, valve, etc.)

Township 10S Range 2W, W.M.
North

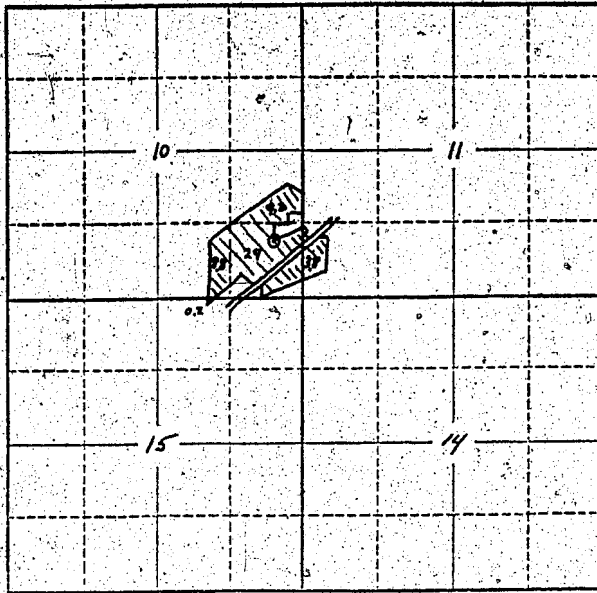

Locate well and acreage of irrigated land on plat.
Scale: 2" = 1 Mile

STATE OF OREGON

County of Linn

} ss.

I, Glen L. and Gloria G. Thurston, being first duly sworn, do hereby certify that I have read the foregoing Registration Statement and that all of the items therein contained are true to the best of my knowledge and belief.

Glen L. Thurston

Gloria G. Thurston
(Signature of Registrant)

Subscribed and sworn to before me this 11th day of January, 1956

My commission expires Aug 4, 1957

Kronala Street
(Notary Public)

(SEAL)

CERTIFICATE OF REGISTRATION

STATE OF OREGON

County of Marion

} ss.

This is to certify that the foregoing Registration Statement was received in the office of the State Engineer on the 13th day of January, 1956, at 8:00 o'clock A.M. and has been duly recorded in said office in Book No. 1 of Registration Statements on page GR-82C.

Construction shall be completed by 15, 1956, and the water completely applied to beneficial use by 10.

Witness my hand this 12th day of April, 1956

Lewis A. Stanley
(State Engineer)

By

(Deputy)

GR-82 C