REGISTRATION NO. GR-795

Registration Statement

CERTIFICATE NO. GR-770

OF CLAIMANT OF RIGHT TO APPROPRIATE GROUND WATER

(Under Chapter 708, Oregon Laws 1955.)

TO THE STATE ENGINEER OF OREGON:

I, L. V. and DONNA LEMIRE

of 4960 Hazel Green Road County of Marion

State of Oregon, do hereby make application for a certificate of registration as evidence of a right to appropriate ground water.

1. **Source** from which water is withdrawn is Pump Well
(Flowing well, pump well, infiltration trench, or tunnel)

2. **Location is:** 5 miles northeast of Salem
(Approximate distance and direction from nearest city or town);

and is more particularly described as follows: 23.82 chains to West quarter corner of Sec. 32 North 39° 58' West T. 6 S. R. 2 W.W.M.

(a) (Give distance and bearing to corner of section or other legal subdivision)

being within the NW¼ of SW¼ (Smallest legal subdivision) of Sec. 32, Twp. 6 S. (N. or S.) Rge. 2 W.W.M. (E. or W.)

or (b) within limits of recorded platted property, town or city:

in Lot ....., Block ..... of ..... (Name of plat or addition)

..... (If within city or town, give name) County of .....

3. **Construction Work** was begun on April 1951 (Date); was completed on April 1951 (Date)

and the ground water claimed was first used for the purposes set out below on May 1, 1951 (Date),

since which time the water has been used continuously (Continuously or intermittently)

from May 1 (Date) to Oct. 1 (Date) to .....

4. **Quantity** of water claimed and used is 450 gallons per minute; 30 acre feet per year.

5. **Purpose or Purposes** for which water is used Irrigation

..... (Domestic, irrigation, municipal, manufacturing, industrial, etc.)

6. **Description of Well:** Depth 110 feet. Type Drilled (Dug or drilled)

diameter 8 inches. Elevation of ground at well site 185 (As near as known) feet, mean sea level.

Depth to water table 35 feet.

7. **Capacity of Well:** 450 g.p.m. with 30 feet drawdown.

..... g.p.m. with ..... feet drawdown.

Date of test .....

If Flowing Well: Measured discharge ..... g.p.m. on ..... (Date)

Shut-in pressure at ground surface ..... lbs. per sq. in. on ..... (Date)

Water is controlled by ..... (Cap, valve, etc.)

8. **Casing:** (Give diameter, commercial specifications and depth below ground surface of each casing size.)

8 inch diameter from 0 to 110 feet

inch diameter from to feet

inch diameter from to feet

inch diameter from to feet

Describe and show depth of shoe, plug, adapter, liner or other details:

9. **Perforated Casings or Screens:**

390 holes from 79 to 100
(Number per foot and size of perforations, or describe screen)

from to

from to

from to

10. **Log of Well:** (Describe each stratum or formation clearly, indicate if water bearing, and give thickness and depth as indicated.)

MATERIAL	Thickness (Feet)	Depth to Bottom (Feet)
Top Soil	3	3
Brown shale	9	12
Brown sandy shale	16	28
Brown sand	28	56
Blue shale	12	68
Brown shale	7	75
Sand and gravel	28	103

GR-770 A

If log of well is not available, give name and address of driller. .....

11. **Infiltration Trench:** Covered or open .....

Dimensions: Length ..... ft. Minimum depth ..... ft. Maximum depth ..... ft.

Bottom width ..... ft. Discharge ..... g.p.m. Date of test .....

12. **Tunnel:** Type of lining .....

Dimensions: .....
(Length, course, and cross sectional size)

Position of water bearing stratum with reference to portal of tunnel .....

Log of tunnel: (Preceding table for log of well may be used, if desired. Give footage from portal and character of materials, as pertinent.)

13. **Pumping Equipment:**

(a) Pump Deep Well Pump (Make, type and size) Capacity 450 g.p.m.

(b) Motor Electric 3 phase Motor 7½ h.P. (Type and horsepower)

14. Location of area irrigated or to be irrigated, or place of use if for purposes other than irrigation.

Township North or South	Range E. or W. of Willamette Meridian	Section	Forty-acre Tract	Number Acres To Be Irrigated	Date of Reclamation
6 S.	2 W	32	NW¼ of SW¼	7.9	May 1951
"	"	"	SW¼ of SW¼	7.11	May 1951
				15.01	

Description of Deed to Laurence V. Lemire and Donna L. Lemire:

Beginning at a point on the north line of the Donation Land Claim of William B. Stevens and wife, 13.56 chains West of the Southeast corner of the Donation Land Claim of Sanford Stephens in Township 6 South, Range 2 West of the Willamette Meridian, Marion County, Oregon; thence South 0° 30' East 20.44 chains to the north line of land owned by George Zellinski; thence South 89° West 7.82 chains along the North line of land owned by George Zellinski and Fred Collins; thence North 0° 30' West 20.56 chains to the North line of the William B. Stephens claim; thence East 7.82 chains to the place of beginning and containing 16.00 acres of land, more or less.

15. If the ground water supply is supplemental to an existing water supply, identification of any application for a permit, permit, certificate or adjudicated right to appropriate water made or held by the registrant.

.....

GR-770 B

Township 6 S. Range 2 W, W.M.

North

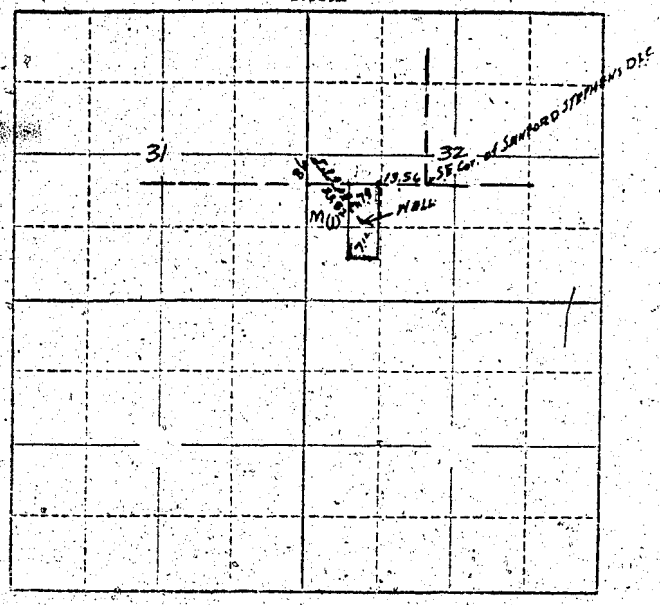

Locate well and acreage of irrigated land on plat.

Scale: 2" = 1 Mile

STATE OF ~~OREGON~~ Montana

County of Broadwater } ss.

I, J. V. Lemire Pump Owner, being first duly sworn, do hereby certify that I have read the foregoing Registration Statement and that all of the items therein contained are true to the best of my knowledge and belief.

J. V. Lemire
(Signature of Registrant)

Subscribed and sworn to before me this 9 day of June, 1958

My commission expires 12-20-60 Melvin M. Grant
(Notary Public)

(SEAL)

CERTIFICATE OF REGISTRATION

STATE OF OREGON
County of Marion } ss.

This is to certify that the foregoing Registration Statement was received in the office of the State Engineer on the 17 day of December, 1957, at 8:00 o'clock A. M. and has been duly recorded in said office in Book No. 4 of Registration Statements on page GR-770 C

~~Construction shall be completed by ..... 19 ..... and the water put to complete beneficial use by ..... 19 .....~~

Witness my hand this 4th day of February, 1958

Lewis A. Stanley
(State Engineer)

$15.00

By .....
(Deputy)

GR-770 C