

# Registration Statement

## OF CLAIMANT OF RIGHT TO APPROPRIATE GROUND WATER

(Under Chapter 708, Oregon Laws 1955.)

TO THE STATE ENGINEER OF OREGON:

I, Lester B. Cowgill  
of Route 3 Box 296 Clatsop County of Clackamas  
State of Oregon, do hereby make application for a certificate of registration as evidence of a right to appropriate ground water.

1. Source from which water is withdrawn is Pump well #A  
(Flowing well, pump well, infiltration trench, or tunnel)
2. Location is: 1/4 mile north of Barlow  
(Approximate distance and direction from nearest city or town)

and is more particularly described as follows:

(a) 660 ft E and 10 ft S from the NW corner of Section 6  
(Give distance and bearing to corner of section or other legal subdivision)  
being within NW 1/4 NE 1/4 of Sec. 6, Twp. 4 S, Rge. 1 E  
(Smallest legal subdivision) (N. or S.) (E. or W.)

or (b) within limits of recorded platted property, town or city:  
in Lot \_\_\_\_\_, Block \_\_\_\_\_ of \_\_\_\_\_  
(Name of plat or addition)  
County of \_\_\_\_\_  
(If within city or town, give name)

3. Construction Work was begun on 1926; was completed on 1926  
(Date) (Date)  
and the ground water claimed was first used for the purposes set out below on 1927  
(Date)  
since which time the water has been used Continuously during irrigation season  
(Continuously or intermittently)  
from 1927 to 1957  
(Date) (Date)

4. Quantity of water claimed and used is 250 gallons per minute; \_\_\_\_\_ acre feet per year. Well fed by underground stream in natural swale.

5. Purpose or Purposes for which water is used Irrigation  
(Domestic, irrigation, municipal, manufacturing, industrial, etc.)

6. Description of Well: Depth 12 feet. Type Dug - Timber cribbed  
(Dug or drilled)  
diameter 5' x 5' inches. Elevation of ground at well site About 100 feet, mean sea level.  
(As near as known)  
Depth to water table 0 to 8 feet.

7. Capacity of Well: 250 g.p.m. with 0 to 8' feet drawdown. changes during summer  
\_\_\_\_\_ g.p.m. with \_\_\_\_\_ feet drawdown.

Date of test 1928

If Flowing Well: Measured discharge \_\_\_\_\_ g.p.m. on \_\_\_\_\_  
(Date)

Shut-in pressure at ground surface \_\_\_\_\_ lbs. per sq. in. on \_\_\_\_\_  
(Date)

Water is controlled by \_\_\_\_\_  
(Cap. valve, etc.)

8. Casing: (Give diameter, commercial specifications and depth below ground surface of each casing size.)

5' x 5' inch diameter *Timber cribbed, dug well* from ..... to ..... feet  
 ..... inch diameter ..... from ..... to ..... feet  
 ..... inch diameter ..... from ..... to ..... feet  
 ..... inch diameter ..... from ..... to ..... feet

Describe and show depth of shoe, plug, adapter, liner or other details: .....

9. Perforated Casings or Screens:


..... from ..... to .....  
 (Number per foot and size of perforations, or describe screen)  
 ..... from ..... to .....  
 ..... from ..... to .....  
 ..... from ..... to .....

10. Log of Well: (Describe each stratum or formation clearly, indicate if water bearing, and give thickness and depth as indicated.)

MATERIAL	Thickness (Feet)	Depth to Bottom (Feet)
<i>Surface muck</i>	<i>4'</i>	<i>8'</i>
<i>Gravel</i>	<i>8'</i>	<i>0"</i>



Township 3 S Range 1 E W.M.  
4 S 1 E  
 North

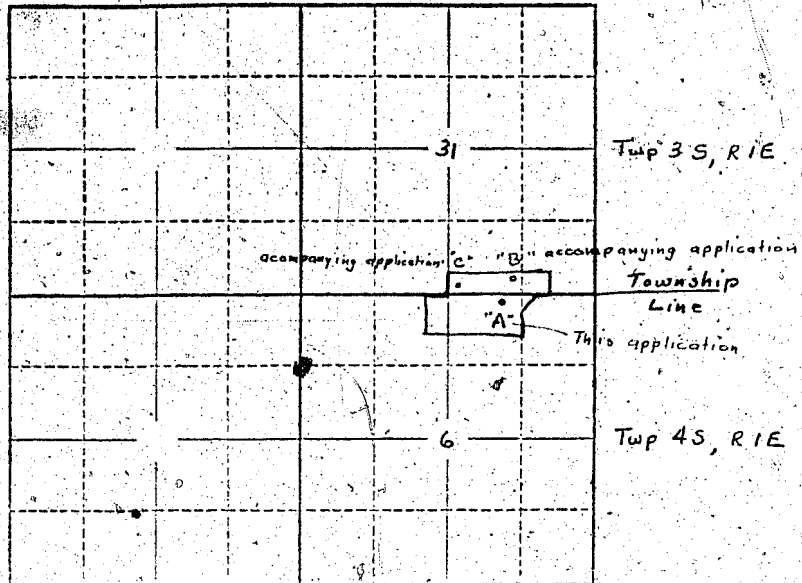

Locate well and acreage of irrigated land on plat.  
 Scale: 2" = 1 Mile

STATE OF OREGON }  
 County of Multnomah } ss.

I, L. B. Cowgill, being first duly sworn, do hereby certify that I have read the foregoing Registration Statement and that all of the items therein contained are true to the best of my knowledge and belief.

L. B. Cowgill  
 (Signature of Registrant)

Subscribed and sworn to before me this 27th day of December, 1957.

My commission expires June 20, 1961  
Forrest Duck  
 (Notary Public)

(SEAL)

**CERTIFICATE OF REGISTRATION**

STATE OF OREGON }  
 County of Marion } ss.

This is to certify that the foregoing Registration Statement was received in the office of the State Engineer on the 18 day of December, 1957, at 8:00 o'clock A. M. and has been duly recorded in said office in Book No. 4 of Registration Statements on page GR-773 C

~~Construction of works completed by \_\_\_\_\_ and the water conveyed, applied to \_\_\_\_\_~~

~~beneficial use by \_\_\_\_\_~~

Witness my hand this 4th day of February, 1958  
Laura A. Stanley  
 (State Engineer)

\$15.00

By \_\_\_\_\_ (Deputy)  
 GR-773 C