

Registration No. GR: 799

Certificate No. GR: 774

Registration Statement

OF CLAIMANT OF RIGHT TO APPROPRIATE GROUND WATER

TO THE STATE ENGINEER OF OREGON:

I, Lester B. Cowgill
of Route 3 Box 296 Canby County of Clackamas
(Mailing address)

State of Oregon, do hereby make application for a certificate of registration as evidence of a right to appropriate ground water.

1. Source from which water is withdrawn is Dug well # 0
(Flowing well, pump well, infiltration trench, or tunnel)

2. Location is: 3/4 mi. N and 1/4 mi. west of Barlow
(Approximate distance and direction from nearest city or town)

and is more particularly described as follows:

(a) 190 ft. N.E. of South 1/4 corner of Sec 31, Twp 3 R 1 E
(Give distance and bearing to corner of section or other legal subdivision)

being within SW 1/4 of SE 1/4 of Sec. 31, Twp. 3 S, Rge. 1 E
(Smallest legal subdivision) (N. or S.) (E. or W.)

or (b) within limits of recorded platted property, town or city:

in Lot _____, Block _____ of _____
(Name of plat or addition)

County of _____
(If within city or town, give name)

3. Construction Work was begun on Before 1926; was completed on Before 1926
(Date) (Date)

and the ground water claimed was first used for the purposes set out below on Before 1926
(Date)

since which time the water has been used Intermittently
(Continuously or intermittently)

from Original date to 1957
(Date) (Date)

4. Quantity of water claimed and used is 350 gallons per minute; _____ acre feet per year.

5. Purpose or Purposes for which water is used irrigation

(Domestic, irrigation, municipal, manufacturing, industrial, etc.)

6. Description of Well: Depth 10 feet. Type Dug well cribbed
(Dug or drilled)

diameter 4' x 6' inches. Elevation of ground at well site 100' feet, mean sea level.
(As near as known)

Depth to water table _____ feet.

7. Capacity of Well: 350 g.p.m. with 4 feet drawdown. changes during season

_____ g.p.m. with _____ feet drawdown.

Date of test Before 1926

If Flowing Well: Measured discharge _____ g.p.m. on _____
(Date)

Shut-in pressure at ground surface _____ lbs. per sq. in. on _____
(Date)

Water is controlled by _____
(Cap, valve, etc.)


8. Casing: (Give diameter, commercial specifications and depth below ground surface of each casing size.)

4 ft x 6 ft inch diameter Timber cribbed from to feet
 inch diameter from to feet
 inch diameter from to feet
 inch diameter from to feet

Describe and show depth of shoe, plug, adapter, liner or other details:

9. Perforated Casings or Screens:

..... from
(Number per foot and size of perforations, or describe screen)
 from
 from
 from

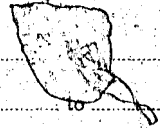

10. Log of Well: (Describe each stratum or formation clearly, indicate if water bearing, and give thickness and depth as indicated.)

MATERIAL	Thickness (Feet)	Depth to Bottom (Feet)
Top muck soil in Pudding river		
overflow channel	3'	7
Peat formation which is very porous	7'	0

If log of well is not available, give name and address of driller:

11. Infiltration Trench: Covered or open

Dimensions: Length ft. Minimum depth ft. Maximum depth ft.

Bottom width ft. Discharge g.p.m. Date of test

12. Tunnel: Type of lining

Dimensions:
(Length, course, and cross sectional size)

Position of water bearing stratum with reference to portal of tunnel

Log of tunnel: (Preceding table for log of well may be used, if desired: Give footage from portal and character of materials, as pertinent.)

13. Pumping Equipment:

(a) Pump Bingham centrifugal pump Capacity 225 g.p.m.
(Make, type and size)


(b) Motor 5 H.P. Gasoline engine
(Type and horsepower)

14. Location of area irrigated or to be irrigated, or place of use if for purposes other than irrigation.

Township North or South	Range E. or W. of Williamsite Meridian	Section	Forty-acre Tract	Number Acres To Be Irrigated	Date of Reclamation
4 S	1 E	6	NW 1/4 of NE 1/4	15	Before 1926
3 S	1 E	31	SW 1/4 of SE 1/4	7	" "
<p>This well used as alternate water source for other wells on same property. This is a very reliable source of water with little draw down and capacity of well is not reliably known.</p> <p>This may be a registered well but its date precedes recent owners and no records are available.</p>					

15. If the ground water supply is supplemental to an existing water supply, identification of any application for a permit, permit, certificate or adjudicated right to appropriate water made or held by the registrant. Original source of irrigation water on the farm shown on next page.

Township 35 Range 1E W.M.
45 North

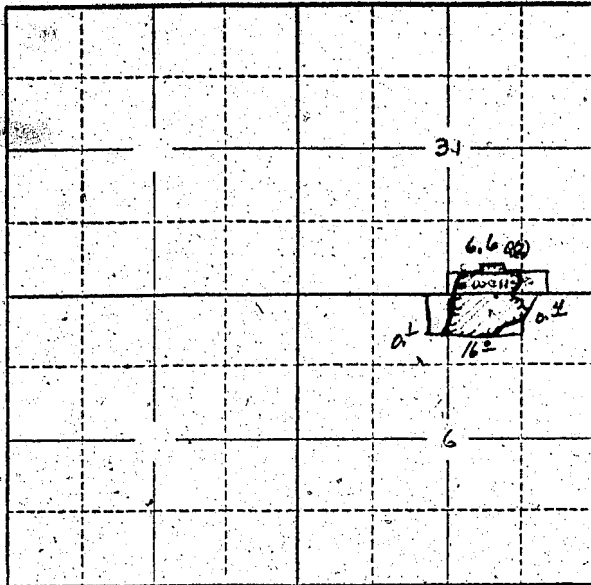

Locate well and acreage of irrigated land on plat.
 Scale: 2" = 1 Mile

STATE OF OREGON

County of Clatsop Multnomah } ss.

I, R. B. Cowgill, being first duly sworn, do hereby certify that I have read the foregoing Registration Statement and that all of the items therein contained are true to the best of my knowledge and belief.

R. B. Cowgill
 (Signature of Registrant)

Subscribed and sworn to before me this 17th day of December, 1957.

My commission expires June 20, 1961

Joseph W. Quick
 (Notary Public)

(SEAL)

CERTIFICATE OF REGISTRATION

STATE OF OREGON

County of Marion } ss.

This is to certify that the foregoing Registration Statement was received in the office of the State Engineer on the 8 day of December, 1957, at 8:00 o'clock A. M. and has been duly recorded in said office in Book No. 4 of Registration Statements on page GR-774 C

Witness my hand this 4th day of February, 1958

Laura A. Stanley
 (State Engineer)

By _____
 (Deputy)

GR - 774 C