

105

Registration Statement

OF CLAIMANT OF RIGHT TO APPROPRIATE GROUND WATER

TO THE STATE ENGINEER OF OREGON:

I, Allen Wilfart
 of 803 W. 5th Albany County of Linn
 State of Oregon, do hereby make application for a certificate of registration as evidence of a right to appropriate ground water.

1. Source from which water is withdrawn is pump well
(Flowing well, pump well, infiltration trench, or tunnel)

2. Location is: 9 mi. W. Jefferson Oregon
(Approximate distance and direction from nearest city or town)

and is more particularly described as follows: Beq. at N.W. corner Sec. 31 - Thence South 27 Chains South - thence East 12 Chains

105 (a) NW 1/4 Sec. 31
(Give distance and bearing to corner of section or other legal subdivision)

being within 31 of Sec. 31, Twp. 9S, Rge. 3W
(Smallest legal subdivision) (N. or S.) (E. or W.)

or (b) within limits of recorded platted property, town or city:

in Lot _____, Block _____ of _____
(Name of plat or addition)

County of Linn
(If within city or town, give name)

3. Construction Work was begun on 1947; was completed on 1947
(Date) (Date)

and the ground water claimed was first used for the purposes set out below on May 1947
(Date)

since which time the water has been used continuously (seasonally)
(Continuous) or intermittently)

from May 47 to Sept 57
(Date) (Date)

4. Quantity of water claimed and used is 500 gallons per minute; _____ acre feet per year.

5. Purpose or Purposes for which water is used irrigation
(Domestic, irrigation, municipal, manufacturing, industrial, etc.)

6. Description of Well: Depth 30 feet. Type: Drilled
(Dug or drilled)

diameter 12 inches. Elevation of ground at well site 175 feet, mean sea level.
(As near as known)

Depth to water table 10 feet.

7. Capacity of Well: 500 g.p.m. with 1 feet drawdown.

1000 g.p.m. with 3 feet drawdown.

Date of test _____

If Flowing Well: Measured discharge _____ g.p.m. on _____
(Date)

Shut-in pressure at ground surface _____ lbs. per sq. in. on _____
(Date)

Water is controlled by _____
(Cap, valve, etc.)

8. Casing: (Give diameter, commercial specifications and depth below ground surface of each casing size.)

12 inch diameter from 0 to 30 feet
 inch diameter from to feet
 inch diameter from to feet
 inch diameter from to feet

Describe and show depth of shoe, plug, adapter, liner or other details:
 none

9. Perforated Casings or Screens:

perforated from 15 to 30
(Number per foot and size of perforations, or describe screen)
 from to
 from to
 from to

10. Log of Well: (Describe each stratum or formation clearly, indicate if water bearing, and give thickness and depth as indicated.)

MATERIAL	Thickness (Feet)	Depth to Bottom (Feet)
<i>silt</i>	<i>12'</i>	<i>12'</i>
<i>gravel</i>	<i>18'</i>	<i>30'</i>

If log of well is not available, give name and address of driller.

11. Infiltration Trench: Covered or open

Dimensions: Length ft. Minimum depth ft. Maximum depth ft.

Bottom width ft. Discharge g.p.m. Date of test

12. Tunnel: Type of lining

Dimensions:
(Length, course, and cross sectional size)

Position of water bearing stratum with reference to portal of tunnel

Log of tunnel: (Preceding table for log of well may be used, if desired. Give footage from portal and character of materials, as pertinent.)

13. Pumping Equipment:

(a) Pump *Cornell* Capacity *500* g.p.m.
(Make, type and size)


(b) Motor *Centrif- 15 H.P.*
(Type and horsepower)

14. Location of area irrigated or to be irrigated, or place of use if for purposes other than irrigation.

Township North or South	Range E. or W. of Willamette Meridian	Section	Forty-acre Tract	Number Acres To Be Irrigated	Date of Reclamation
9S	3W	31	NW ¹ / ₄ or NW ¹ / ₄	15	1947
9S	3W	31	SW ¹ / ₄ of NW ¹ / ₄	15	15

15. If the ground water supply is supplemental to an existing water supply, identification of any application for a permit, permit, certificate or adjudicated right to appropriate water made or held by the registrant.

Township 9S Range 3W -W.M.
North

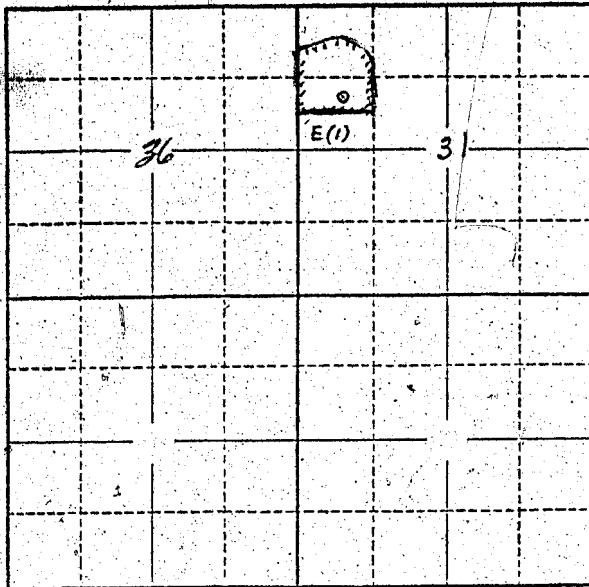

Locate well and acreage of irrigated land on plat.
Scale: 2" = 1 Mile

STATE OF OREGON

County of Linn } ss.

I, Glen H. Willett being first duly sworn, do hereby certify that I have read the foregoing Registration Statement and that all of the items therein contained are true to the best of my knowledge and belief.

Glen H. Willett
(Signature of Registrant)

Subscribed and sworn to before me this 18th day of December, 1957

My commission expires 8/19/59 Harold Carpenter
(Notary Public)

(SEAL)

CERTIFICATE OF REGISTRATION

STATE OF OREGON

County of Marion } ss.

This is to certify that the foregoing Registration Statement was received in the office of the State Engineer on the 18 day of December, 1957, at 8:00 o'clock A. M. and has been duly recorded in said office in Book No. 4 of Registration Statements on page GR 775 C

Witness my hand this 4th day of February, 1958

\$15.00

Lewis A. Stanley
(State Engineer)

By _____ (Deputy)