

Registration Statement

OF CLAIMANT OF RIGHT TO APPROPRIATE GROUND WATER

TO THE STATE ENGINEER OF OREGON:

I, Glen Wilfert

of 803 W. 5th - Albany County of Linn

State of Oregon do hereby make application for a certificate of registration as evidence of a right to appropriate ground water.

1. Source from which water is withdrawn is pump well - #2
(Flowing well, pump well, infiltration trench, or tunnel)

2. Location is: Beq. at the S.W. Corner Sec. 31 - Thence North 330 Chins - East 15 Chins -
(Approximate distance and direction from nearest city or town)

and is more particularly described as follows:

Site # 106 (a) S.W. 1/4 Sec. 31 -
(Give distance and bearing to corner of section or other legal subdivision)

being within N.W. 1/4 of S.W. 1/4 of Sec. 31, Twp. 9S, Rge. 3W
(Smallest legal subdivision) (N. or S.) (E. or W.)

or (b) within limits of recorded platted property, town or city:

in Lot _____, Block _____ of _____
(Name of plat or addition)

County of Linn
(If within city or town, give name)

3. Construction Work was begun on 1951; was completed on 1951
(Date) (Date)

and the ground water claimed was first used for the purposes set out below on 1951
(Date)

since which time the water has been used Continuously
(Continuously or Intermittently)

from May 1951 to Sept. 1957
(Date) (Date)

4. Quantity of water claimed and used is 800 gallons per minute; _____ acre foot per year.

5. Purpose or Purposes for which water is used irrigation

(Domestic, irrigation, municipal, manufacturing, industrial, etc.)

6. Description of Well: Depth 30 feet. Type Drilled
(Dug or drilled)

diameter 1.0 inches. Elevation of ground at well site 175 feet, mean sea level.
(As near as known)

Depth to water table 10 feet.

7. Capacity of Well: 800 g.p.m. with 2 feet drawdown.

(est.) 1,000 g.p.m. with 3 feet drawdown.

Date of test _____

If Flowing Well: Measured discharge _____ g.p.m. on _____
(Date)

Shut-in pressure at ground surface _____ lbs. per sq. in. on _____
(Date)

Water is controlled by _____
(Cap, valve, etc.)

8. Casing: (Give diameter, commercial specifications and depth below ground surface of each casing size.)

1.0 inch diameter from 0 to 30 feet
 inch diameter from to feet
 inch diameter from to feet
 inch diameter from to feet

Describe and show depth of shoe, plug, adapter, liner or other details:

none -

9. Perforated Casings or Screens:

perforated - from 15 to 30
(Number of foot and size of perforations, or describe screen)
 from to
 from to
 from to

10. Log of Well: (Describe each stratum or formation clearly, indicate if water bearing, and give thickness and depth as indicated.)

MATERIAL	Thickness (Feet)	Depth to Bottom (Feet)
<i>silt</i>	<i>12'</i>	<i>12'</i>
<i>gravel</i>	<i>12'</i>	<i>30'</i>

If log of well is not available, give name and address of driller: Hamilton

11. Infiltration Trench: Covered or open
 Dimensions: Length ft. Minimum depth ft. Maximum depth ft.
 Bottom width ft. Discharge g.p.m. Date of test

12. Tunnel: Type of lining
 Dimensions:
(Length, course, and cross sectional size)
 Position of water bearing stratum with reference to portal of tunnel

Log of tunnel: (Preceding table for log of well may be used, if desired. Give footage from portal and character of materials, as pertinent.)


13. Pumping Equipment:
 (a) Pump FN - 10 H.P. - FN. 15 H.P. Capacity 800 g.p.m.
(Make, type and size)
 (b) Motor CO - 15 - 25 H.P. Century
(Type and horsepower)

14. Location of area irrigated or to be irrigated, or place of use if for purposes other than irrigation.

Township North or South	Range E. or W. of Willamette Meridian	Section	Forty-acre Tract	Number Acres To Be Irrigated	Date of Reclamation
95	3W	31	NW 1/4 & SW 1/4	20	1951
98	3W	31	NE 1/4 & SW 1/4	15	"
95	3W	31	SW 1/4 & NW 1/4	15	"
95	3W	31	SE 1/4 & NW 1/4	5	"
				<u>55</u>	

15. If the ground water supply is supplemental to an existing water supply, identification of any application for a permit, permit, certificate or adjudicated right to appropriate water made or held by the registrant.

Township 99 Range 3W, W.M.
North

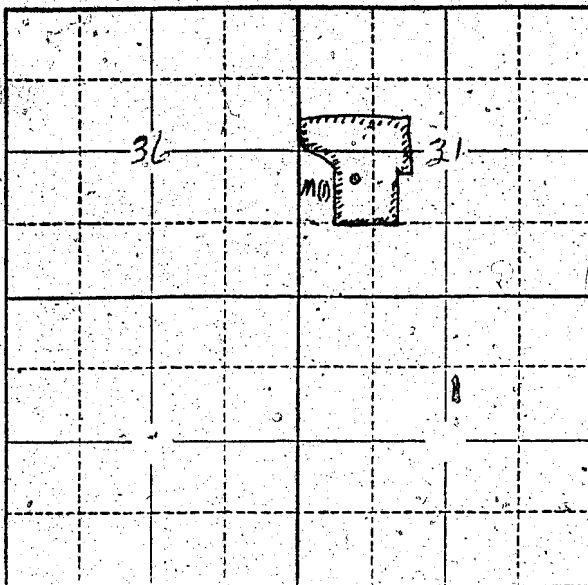

Locate well and acreage of irrigated land on plat.
Scale: 2" = 1 Mile

STATE OF OREGON

County of Linn

} ss.

I, Allen H. Wilfong, being first duly sworn, do hereby certify that I have read the foregoing Registration Statement and that all of the items therein contained are true to the best of my knowledge and belief.

Allen H. Wilfong
(Signature of Registrant)

Subscribed and sworn to before me this 18th day of December, 1957

My commission expires 8/12/59

Harold Campbell
(Notary Public)

(SEAL)

CERTIFICATE OF REGISTRATION

STATE OF OREGON

County of Marion

} ss.

This is to certify that the foregoing Registration Statement was received in the office of the State Engineer on the 18 day of December, 1957, at 8:00 o'clock A. M. and has been duly recorded in said office in Book No. 4 of Registration Statements on page GR-776 C

Witness my hand this 4th day of February, 19 58

Lewis A. Stanley
(State Engineer)

By

(Deputy)

GR-776 C