

Registration Statement

OF CLAIMANT OF RIGHT TO APPROPRIATE GROUND WATER

TO THE STATE ENGINEER OF OREGON:

I, Don h. Turnidge

of Rt. #1 Jetherson County of Melroe

State of Ore. do hereby make application for a certificate of registration as evidence of a right to appropriate ground water.

398

1. Source from which water is withdrawn is pump
(Flowing well, pump well, infiltration trench, or tunnel)

2. Location is: 1/2 mi. west of Jetherson
(Approximate distance and direction from nearest city or town)

and is more particularly described as follows: beg. at the S.W. corner. Sec. 36 thence North 29 chains - thence East 23 chains

(a) 398
(Give distance and bearing to corner of section or other legal subdivision)

being within NE 1/4 of SW 1/4 of Sec. 36, Twp. 23, Rge. 1
(Smallest legal subdivision) (N. or S.) (E. or W.)

or (b) within limits of recorded platted property, town or city:

in Lot _____ Block _____ of _____
(Name of plat or addition)

County of Melroe
(If within city or town, give name)

3. Construction Work was begun on 1941; was completed on 1941
(Date) (Date)

and the ground water claimed was first used for the purposes set out below on 1941
(Date)

since which time the water has been used continuously
(Continuously or intermittently)

from 1941 to 1957
(Date) (Date)

4. Quantity of water claimed and used is 45 gallons per minute, _____ acre feet per year.

5. Purpose or Purposes for which water is used _____
(Domestic, irrigation, municipal, manufacturing, industrial, etc.)

Description of Well: Depth 32 feet. Type _____
(Dug or drilled)

diameter _____ inches. Elevation of ground at well site _____ feet, mean sea level.
(As near as known)

Depth to water table _____ feet.

7. Capacity of Well: 500 g.p.m. with _____ feet drawdown.

1000 g.p.m. with _____ feet drawdown.


Date of test _____

If Flowing Well: Measured discharge _____ g.p.m. on _____
(Date)

Shut-in pressure at ground surface _____ lbs. per sq. in. on _____
(Date)

Water is controlled by _____
(Cap, valve, etc.)

Township 9S Range 4W, W.M.
North

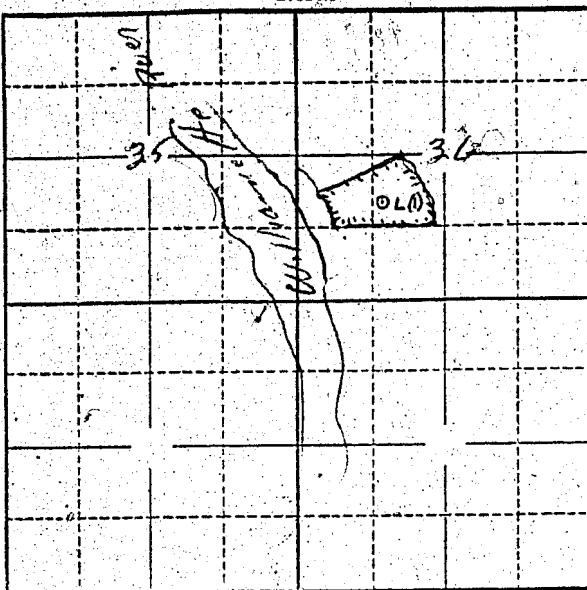

Locate well and acreage of irrigated land on plat.
Scale: 2" = 1 Mile

STATE OF OREGON

County of Marion

} ss.

I, _____, being first duly sworn, do hereby certify that I have read the foregoing Registration Statement and that all of the items therein contained are true to the best of my knowledge and belief.

[Signature]
(Signature of Registrant)

Subscribed and sworn to before me this 18th day of December, 1957.

My commission expires June 12th, 1961

Wm. S. Bartholomew
(Notary Public)

(SEAL)

CERTIFICATE OF REGISTRATION

STATE OF OREGON

County of Marion

} ss.

This is to certify that the foregoing Registration Statement was received in the office of the State Engineer on the 18 day of December, 1957, at 10:30 o'clock A. M. and has been duly recorded in said office in Book No. 4 of Registration Statements on page 777.

Witness my hand this 21 day of February, 1958.

Lewis A. Stanley
(State Engineer)

By _____

(Deputy)