

402

Registration No. GR-807

Certificate No. GR-782

# Registration Statement

## OF CLAIMANT OF RIGHT TO APPROPRIATE GROUND WATER

TO THE STATE ENGINEER OF OREGON:

I, Don L. Turnidge  
of Rt #1 Jefferson Ave County of Marion  
(Mailing address)

State of Oregon, do hereby make application for a certificate of registration as evidence of a right to appropriate ground water.

1. Source from which water is withdrawn is Pump Well  
(Flowing well, pump well, infiltration trench, or tunnel)

2. Location is: 9 mi. West Jefferson  
(Approximate distance and direction from nearest city or town)

and is more particularly described as follows: Sec. 36 - Thence South 36 chains  
Thence East 14 chains

(a) Site #402 NW 1/4 Sec. 36  
(Give distance and bearing to corner of section or other legal subdivision)

being within SW 1/4 NW 1/4 of Sec. 36, Twp. 9 S, Rge. 7 W  
(Smallest legal subdivision) (N. or S.) (E. or W.)

or (b) within limits of recorded platted property, town or city:

in Lot \_\_\_\_\_, Block \_\_\_\_\_ of \_\_\_\_\_  
(Name of plat or addition)

County of Marion  
(If within city or town, give name)

3. Construction Work was begun on 1943; was completed on 1943  
(Date) (Date)

and the ground water claimed was first used for the purposes set out below on May 1943  
(Date)

since which time the water has been used continuously (irrigation)  
(Continuously or intermittently)

from 1943 to 1957  
(Date) (Date)

4. Quantity of water claimed and used is 450-500 gallons per minute; 3 acre feet per year.

5. Purpose or Purposes for which water is used irrigation

(Domestic, irrigation, municipal, manufacturing, industrial, etc.)

6. Description of Well: Depth 30 feet. Type drilled  
(Dug or drilled)

diameter 2 inches. Elevation of ground at well site 175' feet, mean sea level.  
(As near as known)

Depth to water table 10 feet.

7. Capacity of Well: 500 g.p.m. with 7' feet drawdown.

or 1000 g.p.m. with 1' feet drawdown.

Date of test \_\_\_\_\_

If Flowing Well: Measured discharge \_\_\_\_\_ g.p.m. on \_\_\_\_\_  
(Date)


Shut-in pressure at ground surface \_\_\_\_\_ lbs. per sq. in. on \_\_\_\_\_  
(Date)

Water is controlled by \_\_\_\_\_  
(Cap, valve, etc.)





Township 9S Range 4W, W.M.  
North

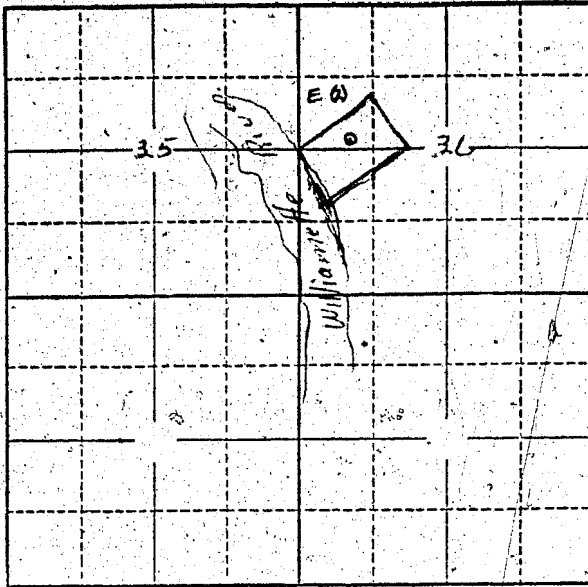

Locate well and acreage of irrigated land on plat.  
Scale: 2" = 1 Mile

STATE OF OREGON }  
County of Marion } ss.

I, \_\_\_\_\_, being first duly sworn, do hereby certify that I have read the foregoing Registration Statement and that all of the items therein contained are true to the best of my knowledge and belief.

Alan L. Purdy  
(Signature of Registrant)

Subscribed and sworn to before me this 18th day of December, 1957

My commission expires June 17, 1961 Wm. S. Bartholomew  
(Notary Public)

(SEAL)

**CERTIFICATE OF REGISTRATION**

STATE OF OREGON }  
County of Marion } ss.

This is to certify that the foregoing Registration Statement was received in the office of the State Engineer on the 18 day of December, 1957, at 10:30 o'clock A.M. and has been duly recorded in said office in Book No. 4 of Registration Statements on page 782

Witness my hand this 21 day of February, 1958

Lura A. Stanley  
(State Engineer)

By \_\_\_\_\_  
(Deputy)

GR - 782 C