

667

1954

Registration No. GR-809

Certificate No. GR-781

Registration Statement

OF CLAIMANT OF RIGHT TO APPROPRIATE GROUND WATER

TO THE STATE ENGINEER OF OREGON:

I, Don L. Turnidge
 of Rt. #1 Jefferson, County of Marion
(Mailing address)
 State of Oregon, do hereby make application for a certificate of registration as evidence
 of a right to appropriate ground water.

1. Source from which water is withdrawn is Pump Well
(Flowing well, pumpwell, infiltration trench, or tunnel)

2. Location is: 9 mi. W. Jefferson
(Approximate distance and direction from nearest city or town)

and is more particularly described as follows: Beg. at the NW corner of Sec. 19 Thence
South 23 chains Thence East 45 chains
1950

(a) 667
(Give distance and bearing to corner of section or other legal subdivision)

being within SW 1/4 of NE 1/4 of Sec. 19, Twp. 9S, Rge. 3W
(Smallest legal subdivision) (N. or S.) (E. or W.)

or (b) within limits of recorded platted property, town or city:

in Lot _____, Block _____ of _____
(Name of plat or addition)

County of _____
(If within city or town, give name)

3. Construction Work was begun on 1954; was completed on 1954
(Date) (Date)

and the ground water claimed was first used for the purposes set out below on 1954
(Date)

since which time the water has been used Continuously (Seasonally)
(Continuously or intermittently)

from May 54 to Sept. 51
(Date) (Date)

4. Quantity of water claimed and used is 200 gallons per minute; _____ acre
 feet per year.

5. Purpose or Purposes for which water is used irrigation

(Domestic, irrigation, municipal, manufacturing, industrial, etc.)

6. Description of Well: Depth 67 feet. Type Drilled
(Dug or drilled)

diameter 12 inches. Elevation of ground at well site 200 feet, mean sea level.
(As near as known)

Depth to water table 30 feet.

7. Capacity of Well: 200 g.p.m. with 1.0 feet drawdown.

_____ g.p.m. with _____ feet drawdown.


Date of test _____

If Flowing Well: Measured discharge _____ g.p.m. on _____
(Date)

Shut-in pressure at ground surface _____ lbs. per sq. in. on _____
(Date)

Water is controlled by _____
(Cap. valve, etc.)

Township 25 Range 3W, W.M.
North

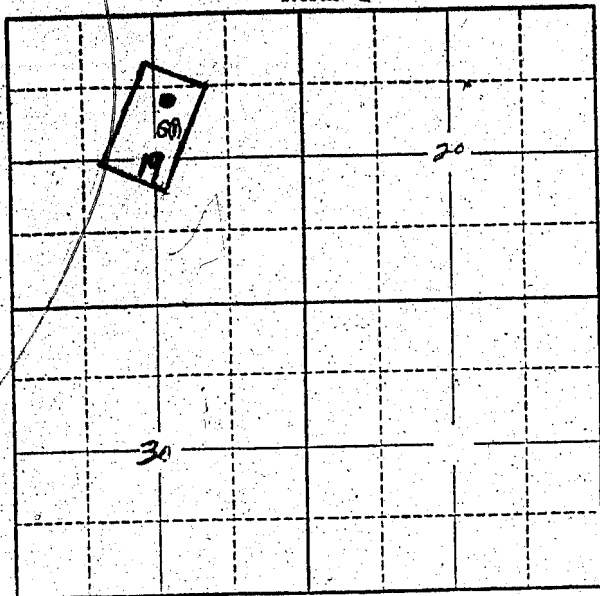

Locate well and acreage of irrigated land on plat.
Scale: 2" = 1 Mile

STATE OF OREGON

County of Marion } ss.

I, _____ being first duly sworn, do hereby certify that I have read the foregoing Registration Statement and that all of the items therein contained are true to the best of my knowledge and belief.

Don L. Pearridge
(Signature of Registrant)

Subscribed and sworn to before me this 18th day of December, 1957

My commission expires June 12th, 1961 Wm. S. Bartholomew
(Notary Public)

(SEAL)

CERTIFICATE OF REGISTRATION

STATE OF OREGON

County of Marion } ss.

This is to certify that the foregoing Registration Statement was received in the office of the State Engineer on the 18 day of December, 1957, at 10:30 o'clock A. M. and has been duly recorded in said office in Book No. 4 of Registration Statements on page 784

Witness my hand this 21 day of February, 1958

Lewis A. Stanley
(State Engineer)

By _____
(Deputy)

\$19.50

GR - 784 C