

Registration Statement

OF CLAIMANT OF RIGHT TO APPROPRIATE GROUND WATER

(Under Chapter 708, Oregon Laws 1955.)

TO THE STATE ENGINEER OF OREGON:

I, A. Louis Steffen

of Woodburn County of Marion

State of Oregon do hereby make application for a certificate of registration as evidence of a right to appropriate ground water:

1. Source from which water is withdrawn is Pump well
(Flowing well, pump well, infiltration trench, or tunnel)

2. Location is: 2 miles southeast of Woodburn, Oregon
(Approximate distance and direction from nearest city or town)

and is more particularly described as follows: 48.70 chains N. 87° 30' W. of the 1/4 cor. between Sections 20 & 21, T. 5 S., R. 1 W. and N. 64° E. 25.80

(a) chains from the SW cor. of the Thomas Fitzgerald D.L.C.
(Give distance and bearing to corner of section or other legal subdivision)

being within SE 1/4 of NW 1/4 of Sec. 20, Twp. 5 S., Rge. 1 W.
(Smallest legal subdivision) (N. or S.) (E. or W.)

or (b) within limits of recorded platted property, town or city:

in Lot _____, Block _____ of _____
(Name of plat or addition)

County of _____
(If within city or town, give name)

3. Construction Work was begun on July 10, 1950; was completed on July 18, 1950
(Date) (Date)

and the ground water claimed was first used for the purposes set out below on August 1, 1950
(Date)

since which time the water has been used every summer.
(Continuously or Intermittently)

from May 1 to October 1 (approximate)
(Date) (Date)

4. Quantity of water claimed and used is 200 gallons per minute; 58 acre feet per year.

5. Purpose or Purposes for which water is used Irrigation

(Domestic, irrigation, municipal, manufacturing, industrial, etc.)

6. Description of Well: Depth 114 feet. Type Drilled

(Dug or drilled)

diameter 8 inches. Elevation of ground at well site 160 feet, mean sea level.
(As near as known)

Depth to water table _____ feet.

7. Capacity of Well: 200 g.p.m. with Unknown feet drawdown.

_____ g.p.m. with _____ feet drawdown.


Date of test Not test pumped but never failed to produce 200 g.p.m.

If Flowing Well: Measured discharge _____ g.p.m. on _____
(Date)

Shut-in pressure at ground surface _____ lbs. per sq. in. on _____
(Date)

Water is controlled by _____
(Cap, valve, etc.)

Township 5 S Range 2 W W.M.
North

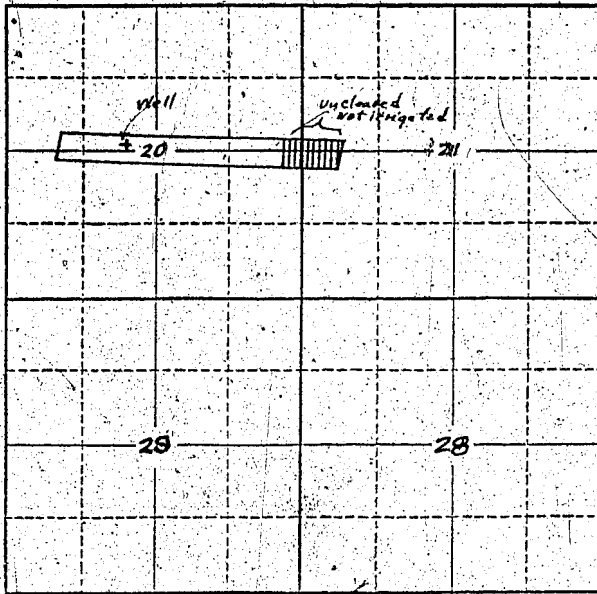

Locate well and acreage of irrigated land on plat.

Scale: 2" = 1 Mile

STATE OF OREGON
County of Marion

SS.

I, A. Louis Steffen, being first duly sworn, do hereby certify that I have read the foregoing Registration Statement and that all of the items therein contained are true to the best of my knowledge and belief.

A. Louis Steffen
(Signature of Registrant)

Subscribed and sworn to before me this 16th day of January, 1956.

My commission expires March 21, 1959

Carrie Housenick
(Notary Public) for Oregon

(SEAL)

CERTIFICATE OF REGISTRATION

STATE OF OREGON
County of Marion

SS.

This is to certify that the foregoing Registration Statement was received in the office of the State Engineer on the 16th day of January, 1956, at 1:00 o'clock P.M. and has been duly recorded in said office in Book No. 1 of Registration Statements on page 70.

Construction shall be completed by _____, 19____, and the water completely applied to beneficial use by _____, 19____.

Witness my hand this 24th day of February, 1956.

Lewis A. Stanley
(State Engineer)

By _____
(Deputy)