

# Registration Statement

## OF CLAIMANT OF RIGHT TO APPROPRIATE GROUND WATER

30

TO THE STATE ENGINEER OF OREGON:

I, Florence M. Cooper

of 510 W. 6th Ave., Albany  
(Mailing address)

County of Linn

State of \_\_\_\_\_, do hereby make application for a certificate of registration as evidence of a right to appropriate ground water.

1. Source from which water is withdrawn is Pump Well No. 9  
(Flowing well, pump well, infiltration trench, or tunnel)

2. Location is: 9 miles north of Albany, Oregon  
(Approximate distance and direction from nearest city or town)

and is more particularly described as follows:

(a) N. 63° 15' E. 8 chains from SW corner of SE $\frac{1}{4}$  of S. 36, T. 9 S. R. 4 W.  
(Give distance and bearing to corner of section or other legal subdivision)

being within SW $\frac{1}{4}$  of SE $\frac{1}{4}$  of Sec. 36, Twp. 9 S., Rge. 4 W.  
(Smallest legal subdivision) (N. or S.) (E. or W.)

or (b) within limits of recorded platted property, town or city:

in Lot \_\_\_\_\_, Block \_\_\_\_\_ of \_\_\_\_\_  
(Name of plat or addition)

County of Linn  
(If within city or town, give name)

3. Construction Work was begun on May 1940; was completed on May 1940  
(Date) (Date)

and the ground water claimed was first used for the purposes set out below on May 1941  
(Date)

since which time the water has been used intermittently  
(Continuously or intermittently)

from May 1941 to present time  
(Date) (Date)

4. Quantity of water claimed and used is 400 gallons per minute; 43.75 acre-feet per year.

5. Purpose or Purposes for which water is used Irrigation

(Domestic, irrigation, municipal, manufacturing, industrial, etc.)

6. Description of Well: Depth 30 feet. Type drilled

diameter 10 inches. Elevation of ground at well site 175 feet, mean sea level.  
(Dug or drilled) (As near as known)

Depth to water table 10 feet.

7. Capacity of Well: 500 g.p.m. with 5 feet drawdown.

\_\_\_\_\_ g.p.m. with \_\_\_\_\_ feet drawdown.

Date of test Estimated - not tested

If Flowing Well: Measured discharge \_\_\_\_\_ g.p.m. on \_\_\_\_\_  
(Date)


Shut-in pressure at ground surface \_\_\_\_\_ lbs. per sq. in. on \_\_\_\_\_  
(Date)

Water is controlled by \_\_\_\_\_  
(Cap. valve, etc.)





Township 9 S Range 4 W. W.M.  
North

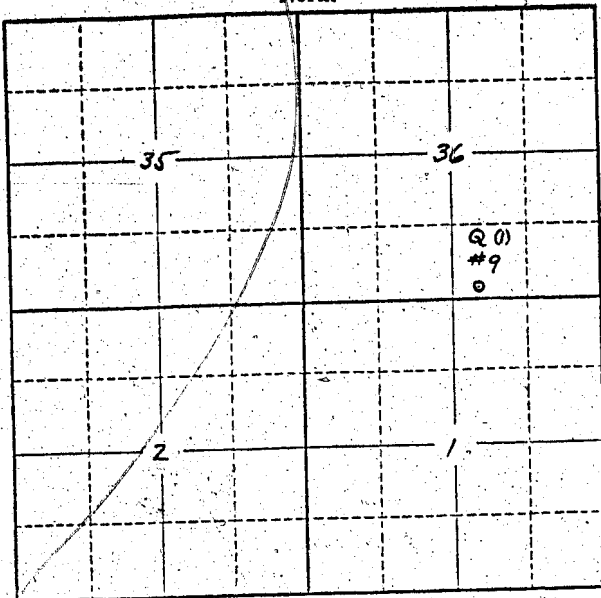

Locate well and acreage of irrigated land on plat.  
Scale: 2" = 1 Mile

STATE OF OREGON }  
County of LINN } ss.

I, Florence M. Cooper, being first duly sworn, do hereby certify that I have read the foregoing Registration Statement and that all of the items therein contained are true to the best of my knowledge and belief.

Florence M. Cooper  
(Signature of Registrant)

Subscribed and sworn to before me this 14th day of December, 1957.

My commission expires March 8, 1958 M. F. Willis  
(Notary Public)

(SEAL)

**CERTIFICATE OF REGISTRATION**

STATE OF OREGON }  
County of Marion } ss.

This is to certify that the foregoing Registration Statement was received in the office of the State Engineer on the 23 day of December, 1957, at 8:00 o'clock A. M. and has been duly recorded in said office in Book No. 4 of Registration Statements on page 796

Witness my hand this 21 day of February, 1958

Lewis A. Stanley  
(State Engineer)

By \_\_\_\_\_  
(Deputy)

\$15.00