

Registration Statement

OF CLAIMANT OF RIGHT TO APPROPRIATE GROUND WATER

TO THE STATE ENGINEER OF OREGON:

I, Mary Annon
of Rt. 2, Box 433, Albany County of Linn
(Mailing address)

State of Oregon, do hereby make application for a certificate of registration as evidence of a right to appropriate ground water.

- Source from which water is withdrawn is Pump Well No. 1
(Flowing well, pump well, infiltration trench, or tunnel)
- Location is: 1 mile SE of Jefferson, Oregon
(Approximate distance and direction from nearest city or town)

and is more particularly described as follows:

(a) N. 47° W. 15.75 chains from SE corner of SW 1/4, S. 11, T. 10 S, R. 3 W.
(Give distance and bearing to corner of section or other legal subdivision)
being within SE 1/4 SW 1/4 Sec. 11, Twp. 10 S, Rge. 3 W.
(Smallest legal subdivision) (N. or S.) (E. or W.)

or (b) within limits of recorded platted property, town or city:
in Lot _____, Block _____ of _____
(Name of plat or addition)
County of Linn
(If within city or town, give name)

3. Construction Work was begun on May 1938; was completed on May 1938
(Date) (Date)
and the ground water claimed was first used for the purposes set out below on May 1938
(Date)
since which time the water has been used continuously
(Continuously or Intermittently)
from May 1938 to present time
(Date) (Date)

4. Quantity of water claimed and used is 350 gallons per minute; 67.25 acre feet per year.

5. Purpose or Purposes for which water is used Irrigation
(Domestic, irrigation, municipal, manufacturing, industrial, etc.)

6. Description of Well: Depth 32 feet. Type Drilled
(Dug or drilled)
diameter 10 inches. Elevation of ground at well site 215 feet, mean sea level.
(As near as known)
Depth to water table 14 feet.

7. Capacity of Well: 350 g.p.m. with 4 feet drawdown.
_____ g.p.m. with _____ feet drawdown.


Date of test Estimated - not tested

If Flowing Well: Measured discharge _____ g.p.m. on _____
(Date)

Shut-in pressure at ground surface _____ lbs. per sq. in. on _____
(Date)

Water is controlled by _____
(Cap, valve, etc.)

Township 10 S Range 3 W W.M.
North

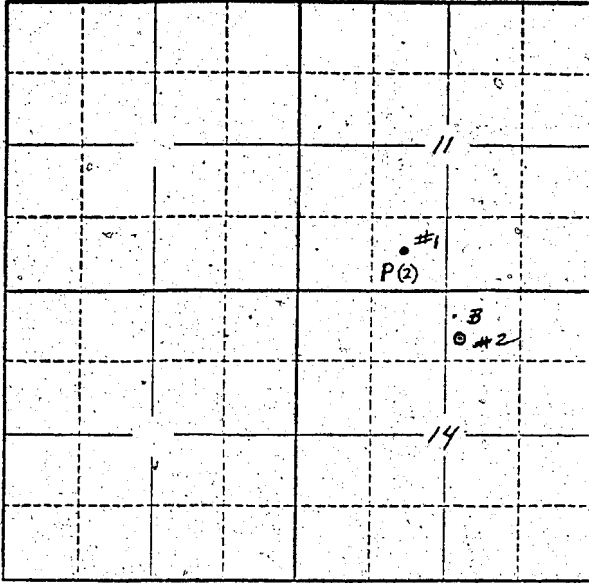

Locate well and acreage of irrigated land on plat.
Scale: 2" = 1 Mile

STATE OF OREGON

County of Linn } ss.

I, Mary Ammon, being first duly sworn, do hereby certify that I have read the foregoing Registration Statement and that all of the items therein contained are true to the best of my knowledge and belief.

Mary Ammon
(Signature of Registrant)

Subscribed and sworn to before me this 24th day of December, 1957

My commission expires MY COMMISSION EXPIRES FEB. 18, 1958

Jeff Caushie
(Notary Public)

(SEAL)

CERTIFICATE OF REGISTRATION

STATE OF OREGON }
County of Marion } ss.

This is to certify that the foregoing Registration Statement was received in the office of the State Engineer on the 22nd day of December, 1957, at _____ o'clock _____ M. and has been duly recorded in said office in Book No. 4 of Registration Statements on page 801

Witness my hand this 21 day of February, 1958

Lewis A. Stanley
(State Engineer)

By _____ (Deputy)