

APPROVED
AUG 23 1957
STATE ENGINEER
SALES

REGISTRATION NO. GR-230
CERTIFICATE NO. GR-803

Registration Statement

OF CLAIMANT OF RIGHT TO APPROPRIATE GROUND WATER

(Under Chapter 708, Oregon Laws 1955.)

TO THE STATE ENGINEER OF OREGON:

I, Oregon Dairy Breeder's Association

of Corvallis County of Benton

State of Oregon, do hereby make application for a certificate of registration as evidence of a right to appropriate ground water.

1. Source from which water is withdrawn is pump well
(Flowing well, pump well, infiltration trench, or tunnel)

2. Location is: 2 miles ^{North} East of Corvallis on Highway 20
(Approximate distance and direction from nearest city or town)

and is more particularly described as follows:

(a) N. 59 degrees 9 min. W. 1055 feet of SW cor. J.S. Kendall D.L.C. #48
(Give distance and bearing to corner of section or other legal subdivision)

being within NE 1/4 of SW 1/4 of Sec. 19, Twp. 11S Rge. 4W
(Smallest legal subdivision) (N. or S.) (E. or W.)

or (b) within limits of recorded platted property, town or city:

in Lot _____, Block _____ of _____
(Name of plat or addition)

County of _____
(If within city or town, give name)

3. Construction Work was begun on 1947; was completed on 1947
(Date) (Date)

and the ground water claimed was first used for the purposes set out below on 1947
(Date)

since which time the water has been used continuously
(Continuously or intermittently)

from 1947 to current
(Date) (Date)

4. Quantity of water claimed and used is 200 gallons per minute; 22.9 acre feet per year.

5. Purpose or Purposes for which water is used irrigation, stock water, and domestic

(Domestic, irrigation, municipal, manufacturing, industrial, etc.)

6. Description of Well: Depth 280 feet. Type drilled
(Dug or drilled)

diameter 8 inches. Elevation of ground at well site 220 feet, mean sea level.
(As near as known)

Depth to water table 29 feet.

7. Capacity of Well: 250 g.p.m. with 17.5 feet drawdown.

_____ g.p.m. with _____ feet drawdown.


Date of test: 1947

If Flowing Well: Measured discharge _____ g.p.m. on _____
(Date)

Shut-in pressure at ground surface _____ lbs. per sq. in. on _____
(Date)

Water is controlled by _____
(Cap. valve, etc.)

Township 11 S Range 4 W V.M.
North

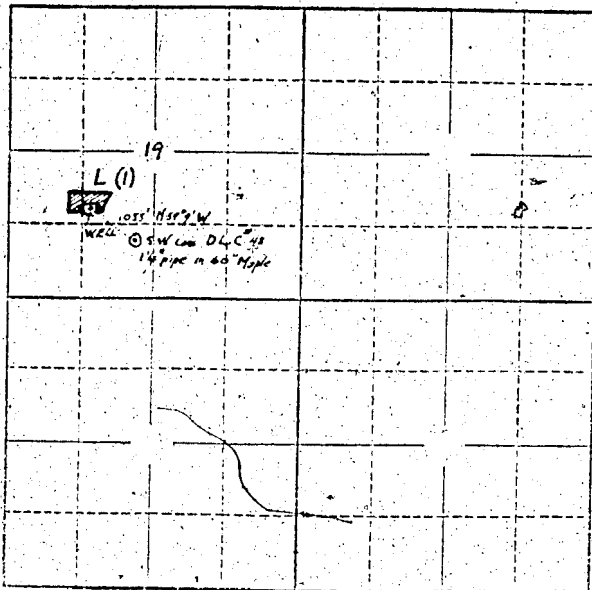

Locate well and acreage of irrigated land on plat.
Scale: 2" = 1 Mile

STATE OF OREGON }
County of Benton } ss.

I, Ira F. Roberts, being first duly sworn, do hereby certify that I have read the foregoing Registration Statement and that all of the items therein contained are true to the best of my knowledge and belief.

Ira F. Roberts
(Signature of Registrant)

Subscribed and sworn to before me this 20th day of December, 1957.

My commission expires 1958
Gladys S. Allen
(Notary Public)

(SEAL)

CERTIFICATE OF REGISTRATION

STATE OF OREGON }
County of Marion } ss.

This is to certify that the foregoing Registration Statement was received in the office of the State Engineer on the 23rd day of December, 1957, at 11:30 o'clock A.M. and has been duly recorded in said office in Book No. 1000 of Registration Statements on page 803.

~~Construction shall be completed by 1958 and the water completely applied to beneficial use by 1958.~~

Witness my hand this 21 day of February, 1958
Lewis A. Stanley
(State Engineer)

\$15.00

By _____ (Deputy)