

Registration Statement

OF CLAIMANT OF RIGHT TO APPROPRIATE GROUND WATER

TO THE STATE ENGINEER OF OREGON:

I, George Earl Milne

of Route 2, Box 136, Tillamook County of Tillamook
(Mailing address)

State of Oregon do hereby make application for a certificate of registration as evidence of a right to appropriate ground water:

1. Source from which water is withdrawn is pump well
(Flowing well, pump well, infiltration trench, or tunnel)
2. Location is: 5 miles southeast of Tillamook
(Approximate distance and direction from nearest city or town)

and is more particularly described as follows:

(a) 700' west and 140' south of corner of NE₁ of NE₁ of Section 16
(Give distance and bearing to corner of section or other legal subdivision)

being within NE₁ of NE₁ of Sec. 16, Twp. 2 South, Rge. 9 West
(Smallest legal subdivision) (N. or S.) (E. or W.)

or (b) within limits of recorded platted property, town or city: _____

in Lot _____, Block _____ of _____
(Name of plat or addition)
 County of _____
(If within city or town, give name)

Construction Work was begun on November 1952; was completed on November 1952
(Date) (Date)

and the ground water claimed was first used for the purposes set out below on May 1, 1953
(Date)

since which time the water has been used continuously during the irrigation season
(Continuously or intermittently)

from 1953 to 1957
(Date) (Date)

4. Quantity of water claimed and used is 40 gallons per minute; 3 acre feet per year.

5. Purpose or Purposes for which water is used irrigation
(Domestic, irrigation, municipal, manufacturing, industrial, etc.)

6. Description of Well: Depth 90 feet. Type drilled
(Dug or drilled)

diameter 9 inches. Elevation of ground at well site 93 feet, mean sea level.
(As near as known)

Depth to water table 3 feet.

7. Capacity of Well: 40 g.p.m. with 60 feet drawdown.

25 g.p.m. with 30 feet drawdown.

Date of test December '52

If Flowing Well: Measured discharge _____ g.p.m. on _____
(Date)

Shut-in pressure at ground surface _____ lbs. per sq. in. on _____
(Date)

Water is controlled by _____
(Cap, valve, etc.)

8. Casing: (Give diameter, commercial specifications and depth below ground surface of each casing size.)

9 inch diameter steel from 0 to 75 feet
inch diameter from to feet
inch diameter from to feet
inch diameter from to feet

Describe and show depth of shoe, plug, adapter, liner or other details: none

9. Perforated Casings or Screens:

six perforations $\frac{1}{8}$ " x 2" each foot from 30 to 50
(Number per foot and size of perforations, or describe screen)
from to
from to
from to

10. Log of Well: (Describe each stratum or formation clearly, indicate if water bearing, and give thickness and depth as indicated.)

MATERIAL	Thickness (Feet)	Depth to Bottom (Feet)
<u>Not available</u>		

If log of well is not available, give name and address of dweller. Mr. Paul Ross who worked out of Tillamook Implement Company, Tillamook at the time the well was drilled.

11. Infiltration Trench: Covered or open
 Dimensions: Length ft. Minimum depth ft. Maximum depth ft.
 Bottom width ft. Discharge g.p.m. Date of test

12. Tunnel: Type of lining
 Dimensions:
(Length, course, and cross sectional size)
 Position of water bearing stratum with reference to portal of tunnel

Log of tunnel: (Preceding table for log of well may be used, if desired. Give footage from portal and character of materials, as pertinent.)

13. Pumping Equipment:
 (a) Pump Pacific Pump Co. submersible Capacity 40 g.p.m.
(Make, type and size)
 (b) Motor Submersible, 4 h.p.
(Type and horsepower)


14. Location of area irrigated or to be irrigated, or place of use if for purposes other than irrigation.

Township North or South	Range E. or W. of Willamette Meridian	Section	Forty-acre Tract	Number Acres To Be Irrigated	Date of Reclamation
2 south	9 west	16	NE $\frac{1}{4}$ of NE $\frac{1}{4}$	10 ²	1953

15. If the ground water supply is supplemental to an existing water supply, identification of any application for a permit, permit, certificate or adjudicated right to appropriate water made or held by the registrant.

nons

Township 2 S. Range 9 W., W.M.
North

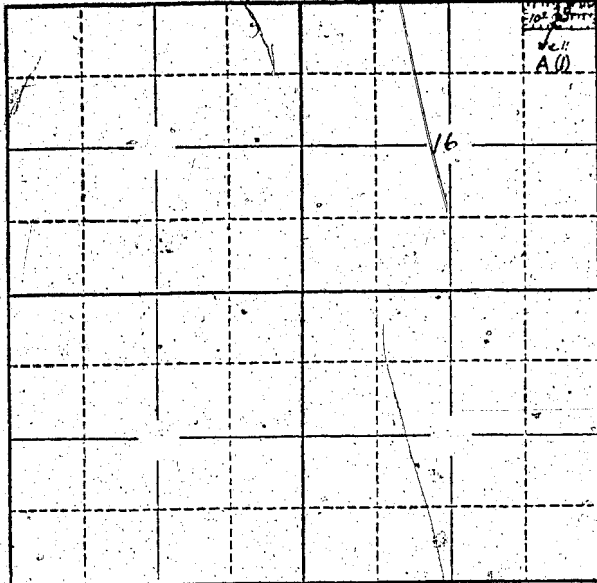

Locate well and acreage of irrigated land on plat.

Scale: 2" = 1 Mile

STATE OF OREGON

County of Tillamook

} ss.

I, George Earl Milne, being first duly sworn, do hereby certify that I have read the foregoing Registration Statement and that all of the items therein contained are true to the best of my knowledge and belief.

George Earl Milne
(Signature of Registrant)

Subscribed and sworn to before me this 3rd day of December, 1957.

My commission expires 9-11-61

Edwin C. Kiehl
(Notary Public)

(SEAL)

CERTIFICATE OF REGISTRATION.

STATE OF OREGON

County of Marion

} ss.

This is to certify that the foregoing Registration Statement was received in the office of the State Engineer on the 27th day of December, 1957, at 2:00 o'clock A. M. and has been duly recorded in said office in Book No. _____ of Registration Statements on page 804.

Witness my hand this 21 day of February, 1958.

Lewis J. Straley
(State Engineer)

By

(Deputy)