

No. 1.

SECTION NO. GR-836  
CERTIFICATE NO. GR-803

# Registration Statement

## OF CLAIMANT OF RIGHT TO APPROPRIATE GROUND WATER

(Under Chapter 708, Oregon Laws 1955.)

TO THE STATE ENGINEER OF OREGON:

I, John C. Johnson  
of Route 4, Box 118 Eugene Ore. County of Lane

State of Ore., do hereby make application for a certificate of registration as evidence of a right to appropriate ground water.

1. Source from which water is withdrawn is infiltration trench # (1)  
(Flowing well, pump well, infiltration trench, or tunnel)

2. Location is: 7 1/2 Mi. south east of Eugene  
(Approximate distance and direction from nearest city or town)

and is more particularly described as follows:

(a) Begin at 1/4 Sec. corner (metal stake)  
(Give distance and bearing to corner of section or other legal subdivision)  
About 700 feet west of 1000 feet south from NE corner section 13.

being within NE 1/4 of NE 1/4 of Sec. 13, Twp. 18 S, Rge. 3 W.  
(Smallest legal subdivision) (N. or S.) (E. or W.)

or (b) within limits of recorded platted property, town or city:

in Lot \_\_\_\_\_ Block \_\_\_\_\_ of \_\_\_\_\_  
(Name of plat or addition)

County of \_\_\_\_\_  
(If within city or town, give name)

3. Construction Work was begun on Oct. 1944; was completed on Summer 1952  
(Date) (Date)

and the ground water claimed was first used for the purposes set out below on Summer 1945.  
(Date)

since which time the water has been used each summer  
(Continuously or Intermittently)

from 1944 to 1955  
(Date) (Date)

4. Quantity of water claimed and used is 156 gallons per minute; 27.3 acre feet per year.

5. Purpose or Purposes for which water is used irrigation

(Domestic, irrigation, municipal, manufacturing, industrial, etc.)

6. Description of Well: Depth \_\_\_\_\_ feet. Type \_\_\_\_\_  
(Dug or drilled)

diameter \_\_\_\_\_ inches. Elevation of ground at well site \_\_\_\_\_ feet, mean sea level.  
(As near as known)

Depth to water table \_\_\_\_\_ feet.

7. Capacity of Well: \_\_\_\_\_ g.p.m. with \_\_\_\_\_ feet drawdown.

\_\_\_\_\_ g.p.m. with \_\_\_\_\_ feet drawdown.

Date of test \_\_\_\_\_

If Flowing Well: Measured discharge \_\_\_\_\_ g.p.m. on \_\_\_\_\_  
(Date)

Shut-in pressure at ground surface \_\_\_\_\_ lbs. per sq. in. on \_\_\_\_\_  
(Date)


Water is controlled by \_\_\_\_\_  
(Cap, valve, etc.)





Township 18.5 Range South 3, W.M.  
North

See Map Well No. I

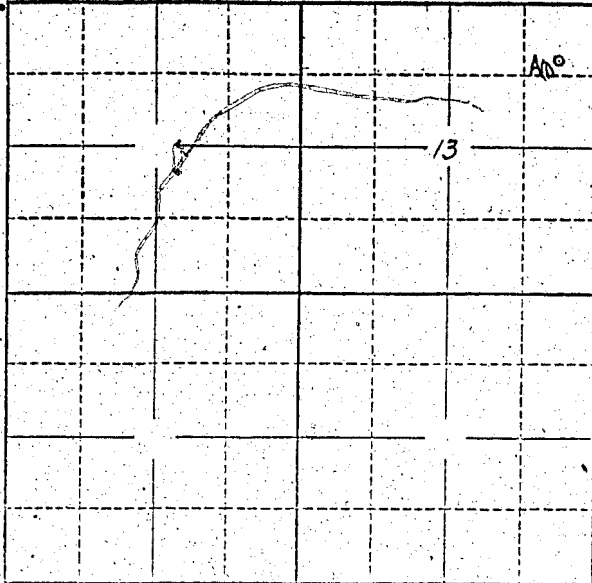

Locate well and acreage of irrigated land on plat.

Scale: 2" = 1 Mile

STATE OF OREGON

County of Lane

} ss.

I, John G. Johnson, being first duly sworn, do hereby certify that I have read the foregoing Registration Statement and that all of the items therein contained are true to the best of my knowledge and belief.

*John G. Johnson*  
(Signature of Registrant)

Subscribed and sworn to before me this 13 day of April, 1958

My commission expires Feb. 7, 1960  
My Commission Expires Feb. 7, 1960

*[Signature]*  
(Notary Public)

(SEAL)

**CERTIFICATE OF REGISTRATION**

STATE OF OREGON

County of Marion

} ss.

This is to certify that the foregoing Registration Statement was received in the office of the State Engineer on the 30 day of December, 1957, at 8:00 o'clock A. M. and has been duly recorded in said office in Book No. 5 of Registration Statements on page 808

~~Construction shall be completed by XXXXXXXXXXXXXXXXXXXX and the water completely applied to beneficial use by XXXXXXXXXXXXXXXXXXXX~~

Witness my hand this 21 day of February, 1958

*Lewis A. Stanley*  
(State Engineer)

By \_\_\_\_\_ (Deputy)

\$15.00

GR-803 C