

REGISTRATION NO. GR-84

DATE NO. GR-71

Registration Statement

OF CLAIMANT OF RIGHT TO APPROPRIATE GROUND WATER

(Under Chapter 703, Oregon Laws 1955.)

TO THE STATE ENGINEER OF OREGON:

I, Tony Olsen and Clara E. Olsen

of Harbor County of Gurry

State of Oregon, do hereby make application for a certificate of registration as evidence of a right to appropriate ground water.

1. Source from which water is withdrawn is in infiltration to open pond

2. Location is: 3 Miles from Brookings Ore

(Approximate distance and direction from nearest city or town)

and is more particularly described as follows:

In Donation Land Claim No. 40

(a) South 800.0 feet and East 1075.0 feet from the 1/4 section corner on the West side of Section

being within NW 1/4 of the SW 1/4 of Sec. 9, Twp. 41 S, Rge. 13 W

(Smallest legal subdivision)

(N. or S.)

(E. or W.)

or (b) within limits of recorded platted property, town or city:

in Lot _____, Block _____ of _____

(Name of plat or addition)

County of _____

(If within city or town, give name)

3. Construction Work was begun on 1952; was completed on 1952

(Date)

(Date)

and the ground water claimed was first used for the purposes set out below on 1952

(Date)

since which time the water has been used During fall growing season only

(Continuously or intermittently)

from 1952 to Dec 1955

(Date)

(Date)

4. Quantity of water claimed and used is 10 C.F.S. during irrigating periods gallons per minute feet per year.

5. Purpose or Purposes for which water is used Irrigation. Commercial plantings of lily bulbs etc.

(Domestic, irrigation, municipal, manufacturing, industrial, etc.)

6. Description of Well: Depth None feet. Type Dug Sump

(Dug or drilled)

diameter _____ inches. Elevation of ground at well site 100 feet, mean sea level.

(As near as known)

Depth to water table _____ feet.

7. Capacity of Well: _____ g.p.m. with _____ feet drawdown.

_____ g.p.m. with _____ feet drawdown.

Date of test _____

If Flowing Well: Measured discharge _____ g.p.m. on _____

(Date)


Shut-in pressure at ground surface _____ lbs. per sq. in. on _____

(Date)

Water is controlled by _____

(Cap, valve, etc.)

Township 41. S Range 18. W, W.M.
North

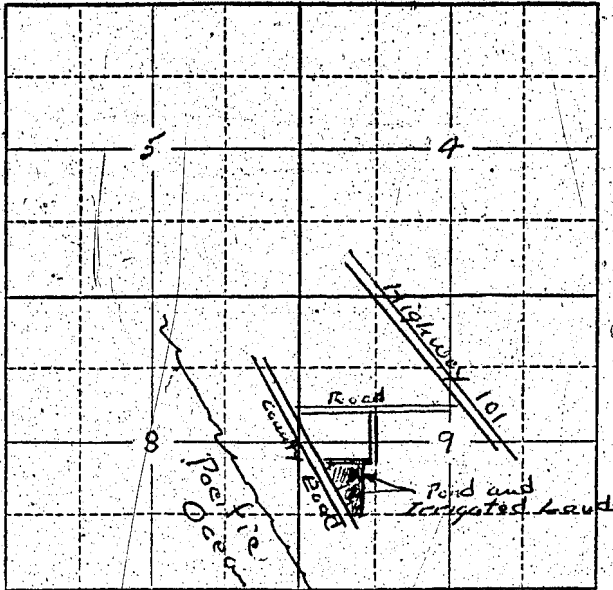

Locate well and acreage of irrigated land on plat.
Scale: 2" = 1 Mile

STATE OF OREGON

County of Curry

SS.

I, Tony Olsen and Clara E. Olsen, being first duly sworn, do hereby certify that I have read the foregoing Registration Statement and that all of the items therein contained are true to the best of my knowledge and belief.

Tony Olsen
Clara E. Olsen
(Signature of Registrant)

Subscribed and sworn to before me this 5 day of January, 1956

My commission expires Apr 7 1958 Harriet E. Payne
(Notary Public)

(SEAL)

CERTIFICATE OF REGISTRATION

STATE OF OREGON

County of Marion

SS.

This is to certify that the foregoing Registration Statement was received in the office of the State Engineer on the 10th day of January, 1956, at 8:00 o'clock A. M. and has been duly recorded in said office in Book No. 1 of Registration Statements on page 71

Construction shall be completed by 15, 1956, and the water, completely applied to beneficial use by 15, 1956

Witness my hand this 24th day of February, 1956

Lewis A. Stanley
(State Engineer)

By _____
(Deputy)